


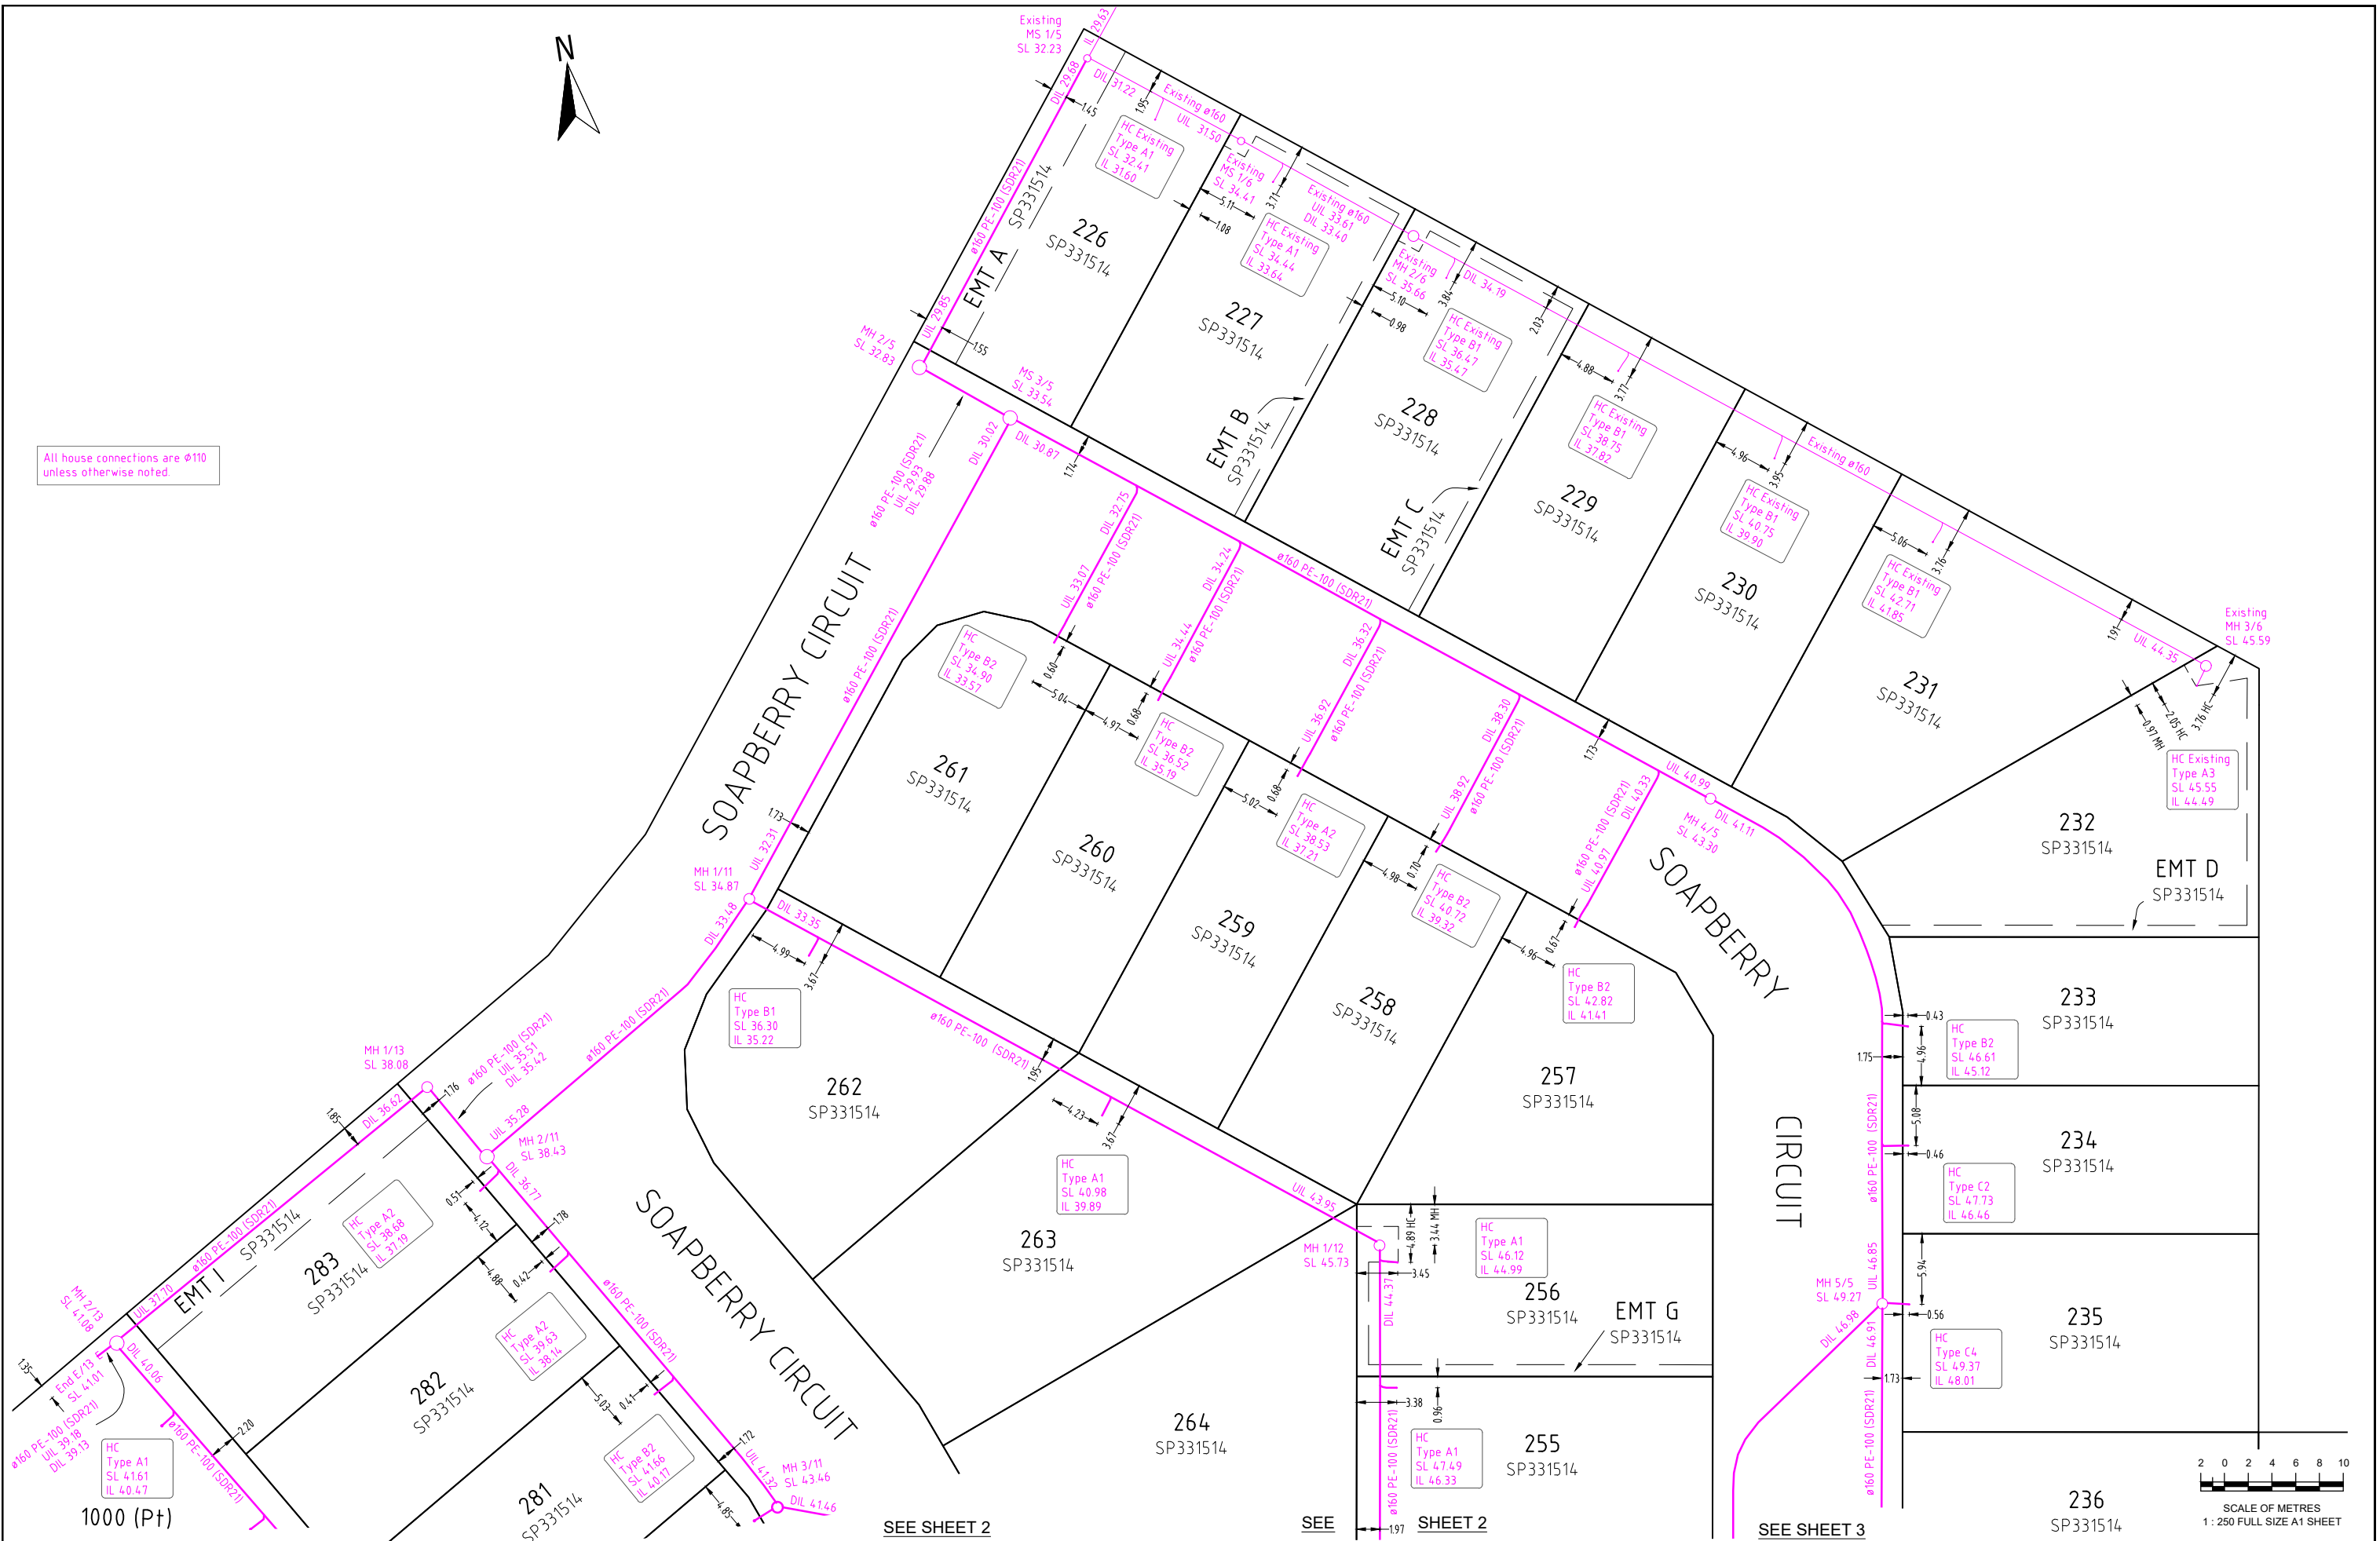

All house connections are $\phi 110$ unless otherwise noted



A1	REV NO	DATE	REVISION PURPOSE / DESCRIPTION	DRAWN	RPEQ	RPEQ No
	A	17.08.2023	Builders Issue			

DRAWN	MD	15.08.2023
CHECKED	CU	15.08.2023
APPROVED		

SH saunders havill group
 Saunders Havill Group Pty Ltd ABN 54 144 572 540
 head office 9 Thompson St Bowen Hills Q 4006
 phone 090 83 5HG web www.saundershavill.com
 ■ surveying ■ town planning ■ urban design ■ environmental management ■ landscape architecture
 Drawing No: 9641 S 38 AC A

UrbanUtilities

THE POCKET - STAGE 4
JO-ANN MILLER DRIVE, COLLINGWOOD PARK
PLAN OF ADAC SURVEY DATA
SEWERAGE RETICULATION 21-PNT-54071



DRAWING STATUS	
AS CONSTRUCTED	
SHEET 1 OF 3 SHEETS	
DRAWING NO.	REV.
	A



All house connections are $\phi 110$ unless otherwise noted.

SEE SHEET 2

SEE SHEET 1

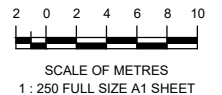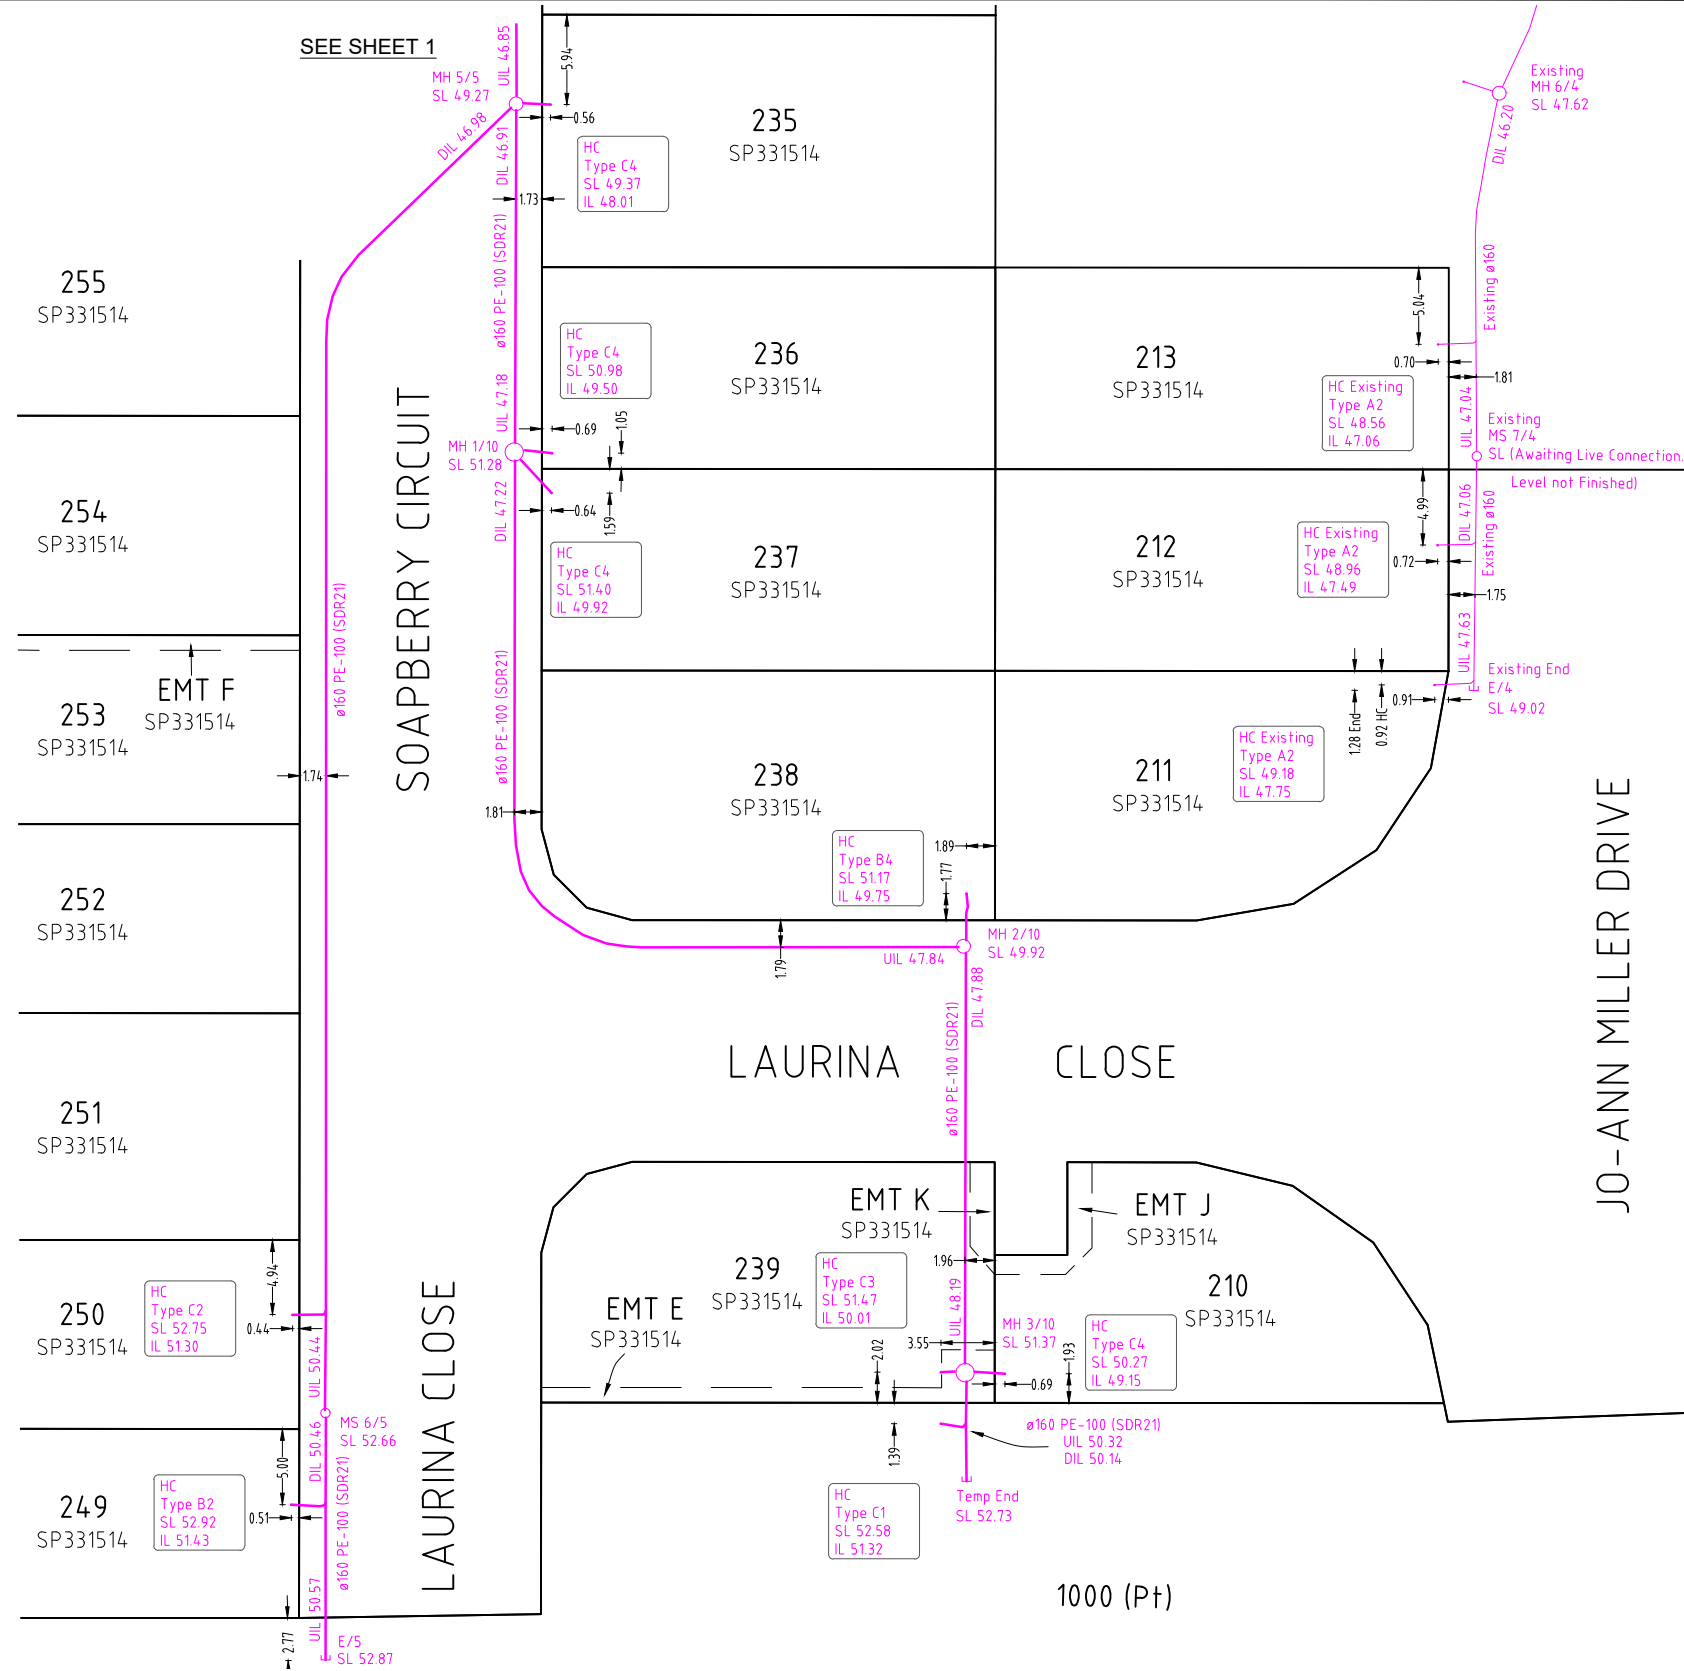

SCALE OF METRES
1 : 250 FULL SIZE A1 SHEET

A1

REV NO	DATE	REVISION PURPOSE / DESCRIPTION	DRAWN	RPEQ	RPEQ No
A	17.08.2023	Builders Issue			

DRAWN	MD	15.08.2023
CHECKED	CU	15.08.2023
APPROVED		


saunders havill group
 Saunders Havill Group Pty Ltd ABN 24 144 592 549
 head office 9 Thompson St Bowen Hills Q 4006
 phone: 090 433 5142 web: www.saundershavill.com
 ■ surveying ■ town planning ■ urban design ■ environmental management ■ landscape architecture




THE POCKET - STAGE 4
 JO-ANN MILLER DRIVE, COLLINGWOOD PARK
 PLAN OF ADAC SURVEY DATA
 SEWERAGE RETICULATION 21-PNT-54071

DRAWING STATUS AS CONSTRUCTED	
SHEET 3 OF 3 SHEETS	
DRAWING NO.	REV. A

Drawing No: 9641 S 38 AC A

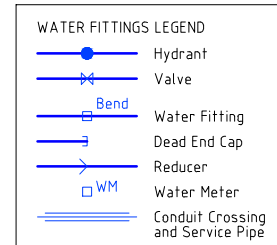

Note: See ADAC xml file for full attribute information

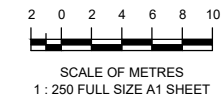

A1										
REV NO	DATE	REVISION PURPOSE / DESCRIPTION	DRAWN	RPEQ	RPEQ No	INITIALS	DATE			
A	17.08.2023	Builders Issue								

DRAWN	MD	15.08.2023
CHECKED	CU	15.08.2023
APPROVED		

SH saunders havill group
 Saunders Havill Group Pty Ltd ABN 54 144 572 540
 head office 9 Thompson St Bowen Hills Q 4006
 phone: 0900 833 516 web: www.saundershavill.com
 ■ surveying ■ town planning ■ urban design ■ environmental management ■ landscape architecture

Drawing No: 9641 S 38 AC A



THE POCKET - STAGE 4
JO-ANN MILLER DRIVE, COLLINGWOOD PARK
PLAN OF ADAC SURVEY DATA
WATER RETICULATION 21-PNT-54071

DRAWING STATUS AS CONSTRUCTED	
SHEET 1 OF 3 SHEETS	
DRAWING NO.	REV.
	A



SEE SHEET 1

SEE SHEET 1


1000 (Pt)

WATER FITTINGS LEGEND	
	Hydrant
	Valve
	Bend
	Water Fitting
	Dead End Cap
	Reducer
	Water Meter
	Conduit Crossing and Service Pipe

Note: See ADAC xml file for full attribute information



SEE SHEET 3

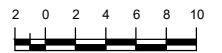

SCALE OF METRES
1 : 250 FULL SIZE A1 SHEET

A1

REV NO	DATE	REVISION PURPOSE / DESCRIPTION	DRAWN	RPEQ	RPEQ No
A	17.08.2023	Builders Issue			

DRAWN	MD	15.08.2023
CHECKED	CU	15.08.2023
APPROVED		

saunders havill group
 Saunders Havill Group Pty Ltd ABN 24 144 592 549
 head office 9 Thompson St Bowen Hills Q 4006
 phone 090 493 5142 web www.saundershavill.com
 ■ surveying ■ town planning ■ urban design ■ environmental management ■ landscape architecture



THE POCKET - STAGE 4
 JO-ANN MILLER DRIVE, COLLINGWOOD PARK
 PLAN OF ADAC SURVEY DATA
 WATER RETICULATION 21-PNT-54071

DRAWING STATUS AS CONSTRUCTED	
SHEET 2 OF 3 SHEETS	
DRAWING NO.	REV. A

Drawing No: 9641 S 38 AC A

