

10 0 10 20 30 40 50
 SCALE OF METRES
 1 : 1000 FULL SIZE A1 SHEET

A1

REV NO	DATE	REVISION PURPOSE / DESCRIPTION	DRAWN	RPEQ	RPEQ No
A	29.11.2023	Builders Issue			

DRAWN	TG	21.11.2023
CHECKED	CU	06.12.2023
APPROVED		

SH saunders havill group
 Saunders Havill Group Pty Ltd ABN 24 144 592 5403
 head office 9 Thompson St Bowen Hills Q 4006
 phone 0900 623 5142 web www.saundershavill.com
 ■ surveying ■ town planning ■ urban design ■ environmental management ■ landscape architecture





THE POCKET - STAGE 5A & 5B
 JO-ANN MILLER DRIVE, COLLINGWOOD PARK
 PLAN OF ADAC SURVEY DATA
 SEWERAGE RETICULATION 22-PNT-63005

DRAWING STATUS AS CONSTRUCTED	
SHEET 1 OF 5 SHEETS	
DRAWING NO.	REV. A


Drawing No: 9641 S 43 AC A

SEE SHEET 5

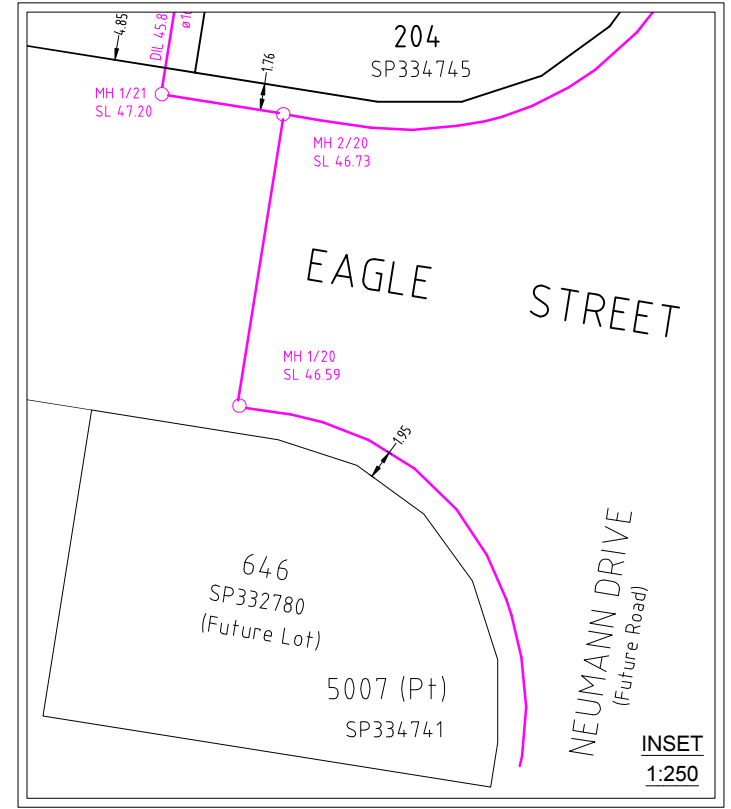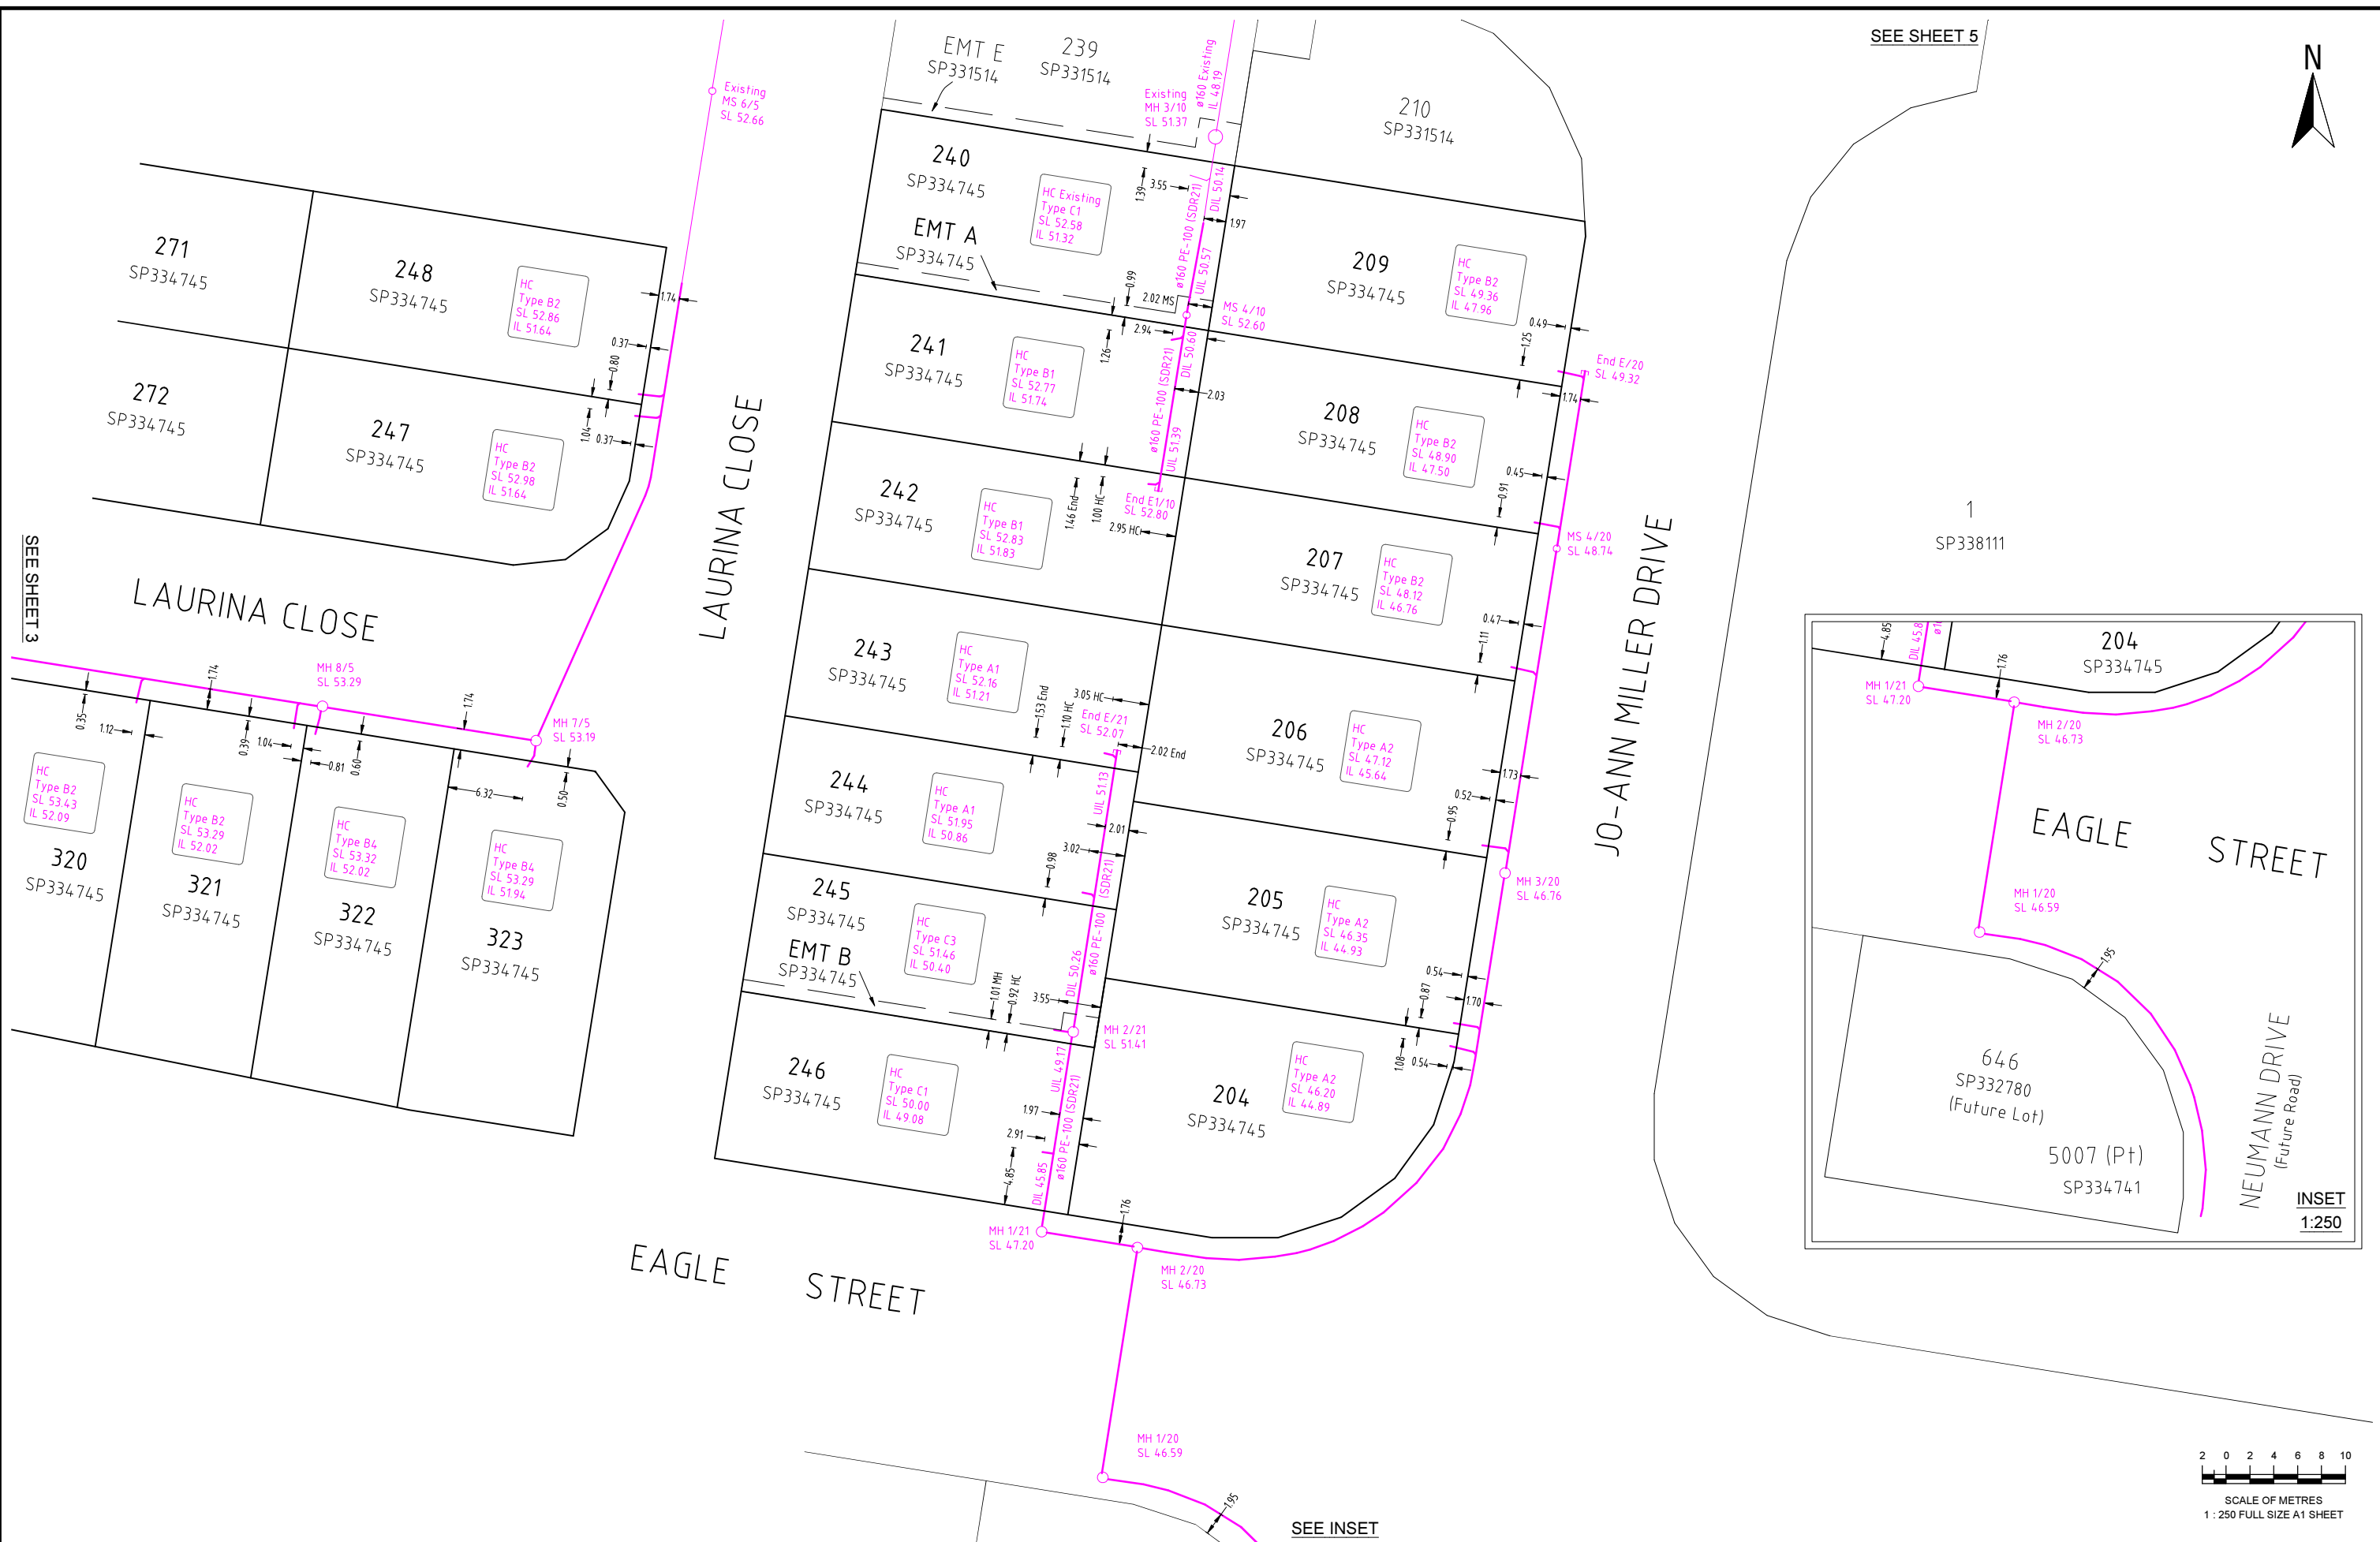

SEE SHEET 3

SEE INSET

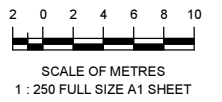


A1										
	REV NO	DATE	REVISION PURPOSE / DESCRIPTION	DRAWN	RPEQ	RPEQ No	INITIALS	DATE		
	A	29.11.2023	Builders Issue							

DRAWN	TG	21.11.2023
CHECKED	CU	06.12.2023
APPROVED		



THE POCKET - STAGE 5A & 5B
 JO-ANN MILLER DRIVE, COLLINGWOOD PARK
 PLAN OF ADAC SURVEY DATA
 SEWERAGE RETICULATION 22-PNT-63005

DRAWING STATUS AS CONSTRUCTED	
SHEET 2 OF 5 SHEETS	
DRAWING NO.	REV.
	A

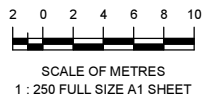

A1	REV NO	DATE	REVISION PURPOSE / DESCRIPTION	DRAWN	RPEQ	RPEQ No
	A	29.11.2023	Builders Issue			

DRAWN	TG	21.11.2023
CHECKED	CU	06.12.2023
APPROVED		


saunders havill group
 Saunders Havill Group Pty Ltd ABN 24 44 592 549
 head office 9 Thompson St Bowen Hills Q 4006
 phone (030) 453 5146 web www.saundershavill.com
 ■ surveying ■ town planning ■ urban design ■ environmental management ■ landscape architecture

UrbanUtilities

THE POCKET - STAGE 5A & 5B
 JO-ANN MILLER DRIVE, COLLINGWOOD PARK
 PLAN OF ADAC SURVEY DATA
 SEWERAGE RETICULATION 22-PNT-63005

DRAWING STATUS AS CONSTRUCTED	
SHEET 3 OF 5 SHEETS	
DRAWING NO.	REV.
	A

COLLINGWOOD DRIVE

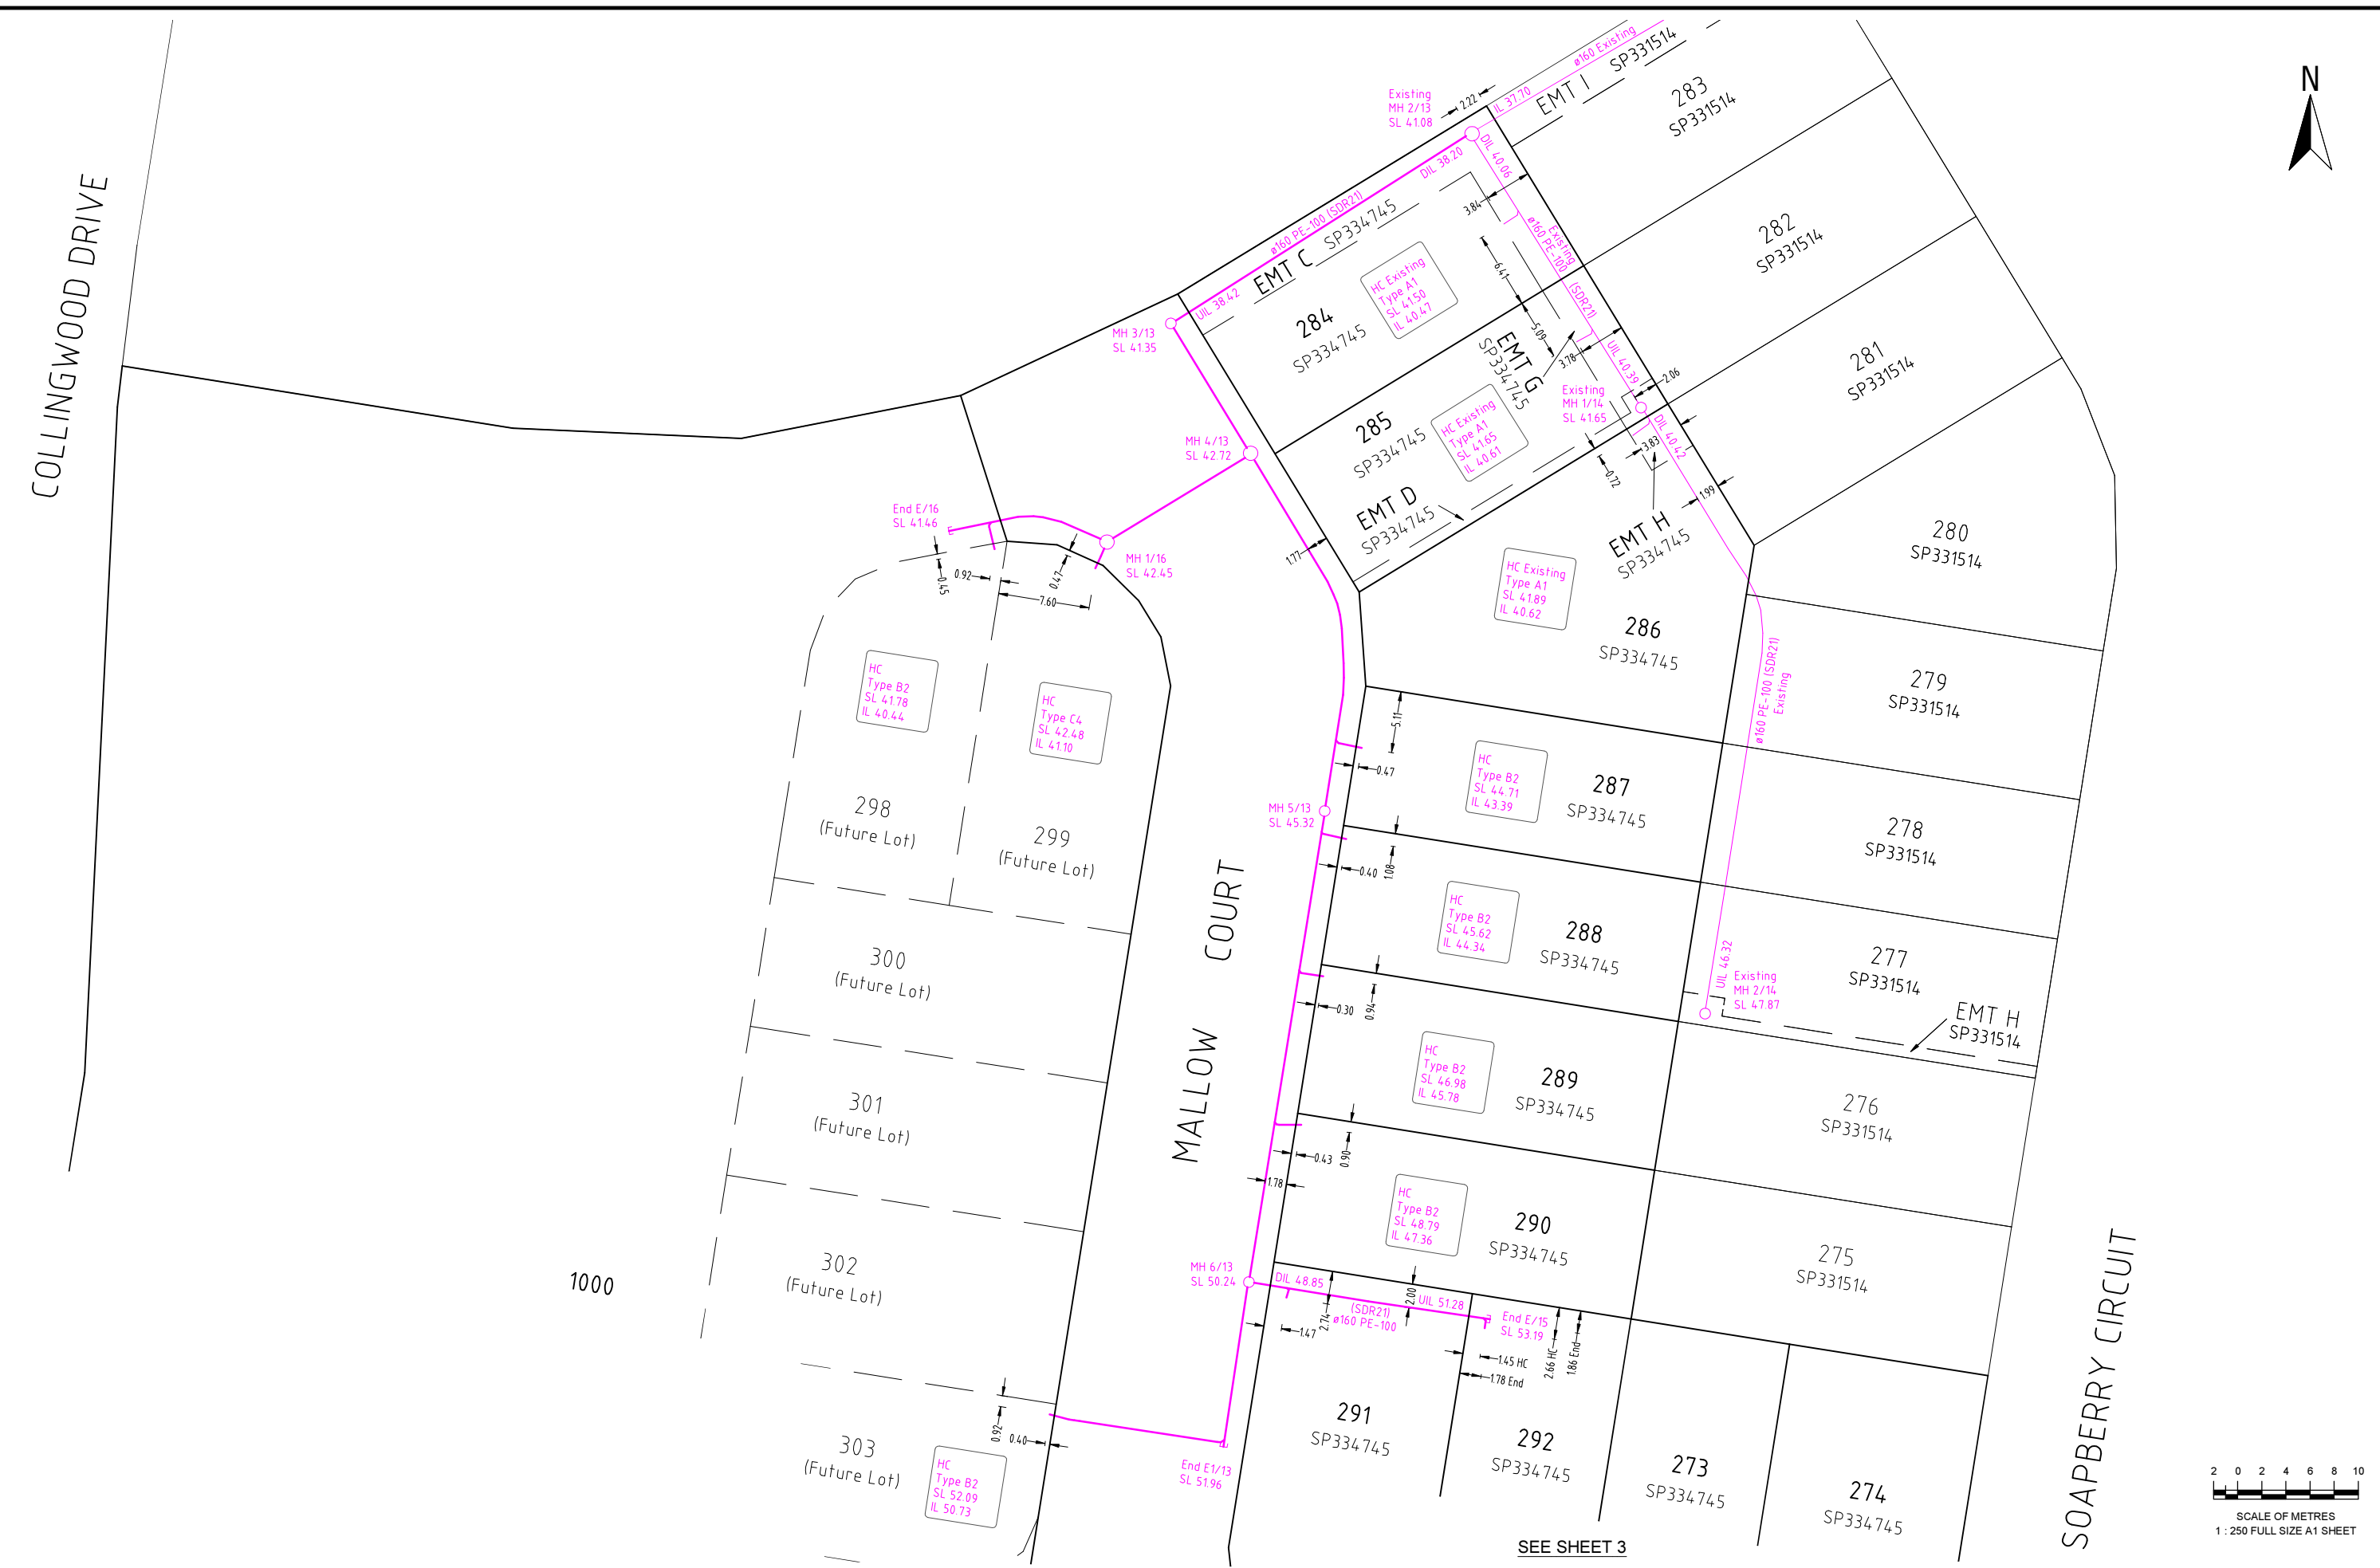


1000

MALLOW COURT

SEE SHEET 3

SOAPBERRY CIRCUIT

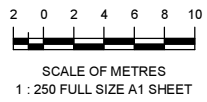

A1

REV NO	DATE	REVISION PURPOSE / DESCRIPTION	DRAWN	RPEQ	RPEQ No
A	29.11.2023	Builders Issue			

DRAWN	TG	21.11.2023
CHECKED	CU	06.12.2023
APPROVED		

saunders havill group
 Saunders Havill Group Pty Ltd ABN 24 44 592 549
 head office 9 Thompson St Bowen Hills Q 4006
 phone 0300 423 594 web www.saundershavill.com
 ■ surveying ■ town planning ■ urban design ■ environmental management ■ landscape architecture



THE POCKET - STAGE 5A & 5B
 JO-ANN MILLER DRIVE, COLLINGWOOD PARK
 PLAN OF ADAC SURVEY DATA
 SEWERAGE RETICULATION 22-PNT-63005

DRAWING STATUS AS CONSTRUCTED	
SHEET 4 OF 5 SHEETS	
DRAWING NO.	REV. A




SEE SHEET 2

JO-ANN MILLER DRIVE

JO-ANN MILLER DRIVE

DRIVE

1
SP338111

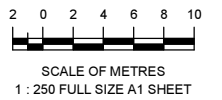

A1

REV NO	DATE	REVISION PURPOSE / DESCRIPTION	DRAWN	RPEQ	RPEQ No	INITIALS	DATE
A	29.11.2023	Builders Issue					

DRAWN	TG	21.11.2023
CHECKED	CU	06.12.2023
APPROVED		


saunders havill group
 Saunders Havill Group Pty Ltd ABN 24 44 572 549
 head office 9 Thompson St Bowen Hills Q 4006
 phone (0)2 433 5146 web www.saundershavill.com
 ■ surveying ■ town planning ■ urban design ■ environmental management ■ landscape architecture

Drawing No: 9641 S 43 AC A

UrbanUtilities


THE POCKET - STAGE 5A & 5B
 JO-ANN MILLER DRIVE, COLLINGWOOD PARK
 PLAN OF ADAC SURVEY DATA
 SEWERAGE RETICULATION 22-PNT-63005

DRAWING STATUS	
AS CONSTRUCTED	
SHEET 5 OF 5 SHEETS	
DRAWING NO.	REV.
	A

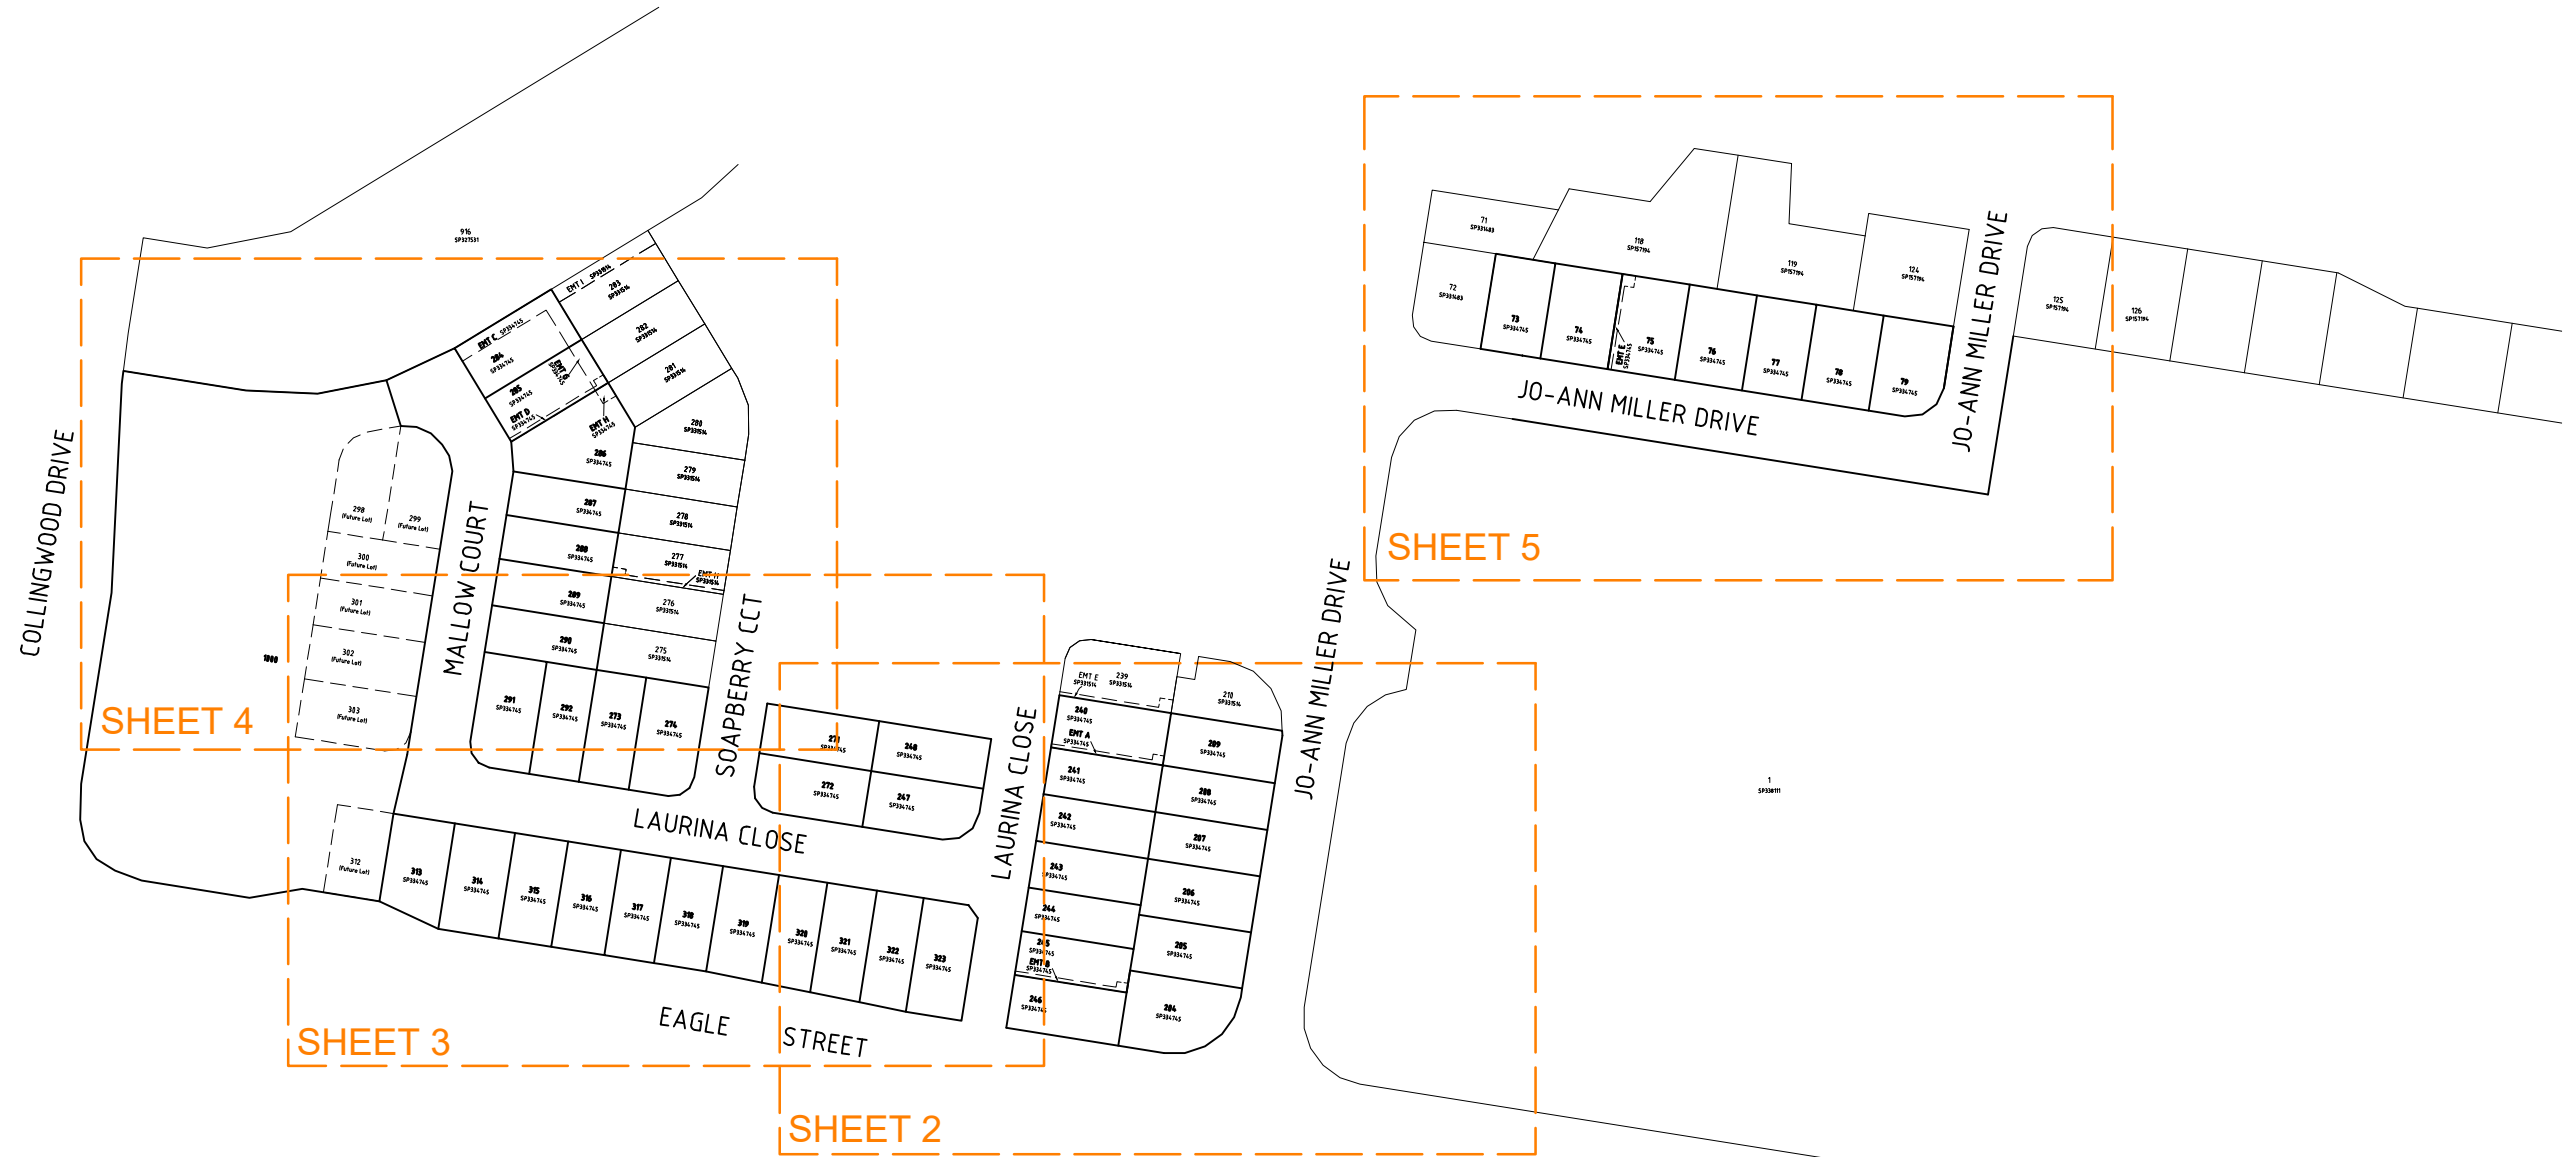

WATER FITTINGS LEGEND

	Hydrant
	Valve
	Bend
	Water Fitting
	Dead End Cap
	Reducer
	Water Meter
	Conduit Crossing and Service Pipe

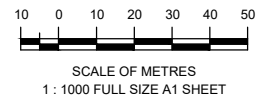

A1

REV NO	DATE	REVISION PURPOSE / DESCRIPTION	DRAWN	RPEQ	RPEQ No
A	29.11.2023	Builders Issue			

DRAWN	TG	21.11.2023
CHECKED	CU	06.12.2023
APPROVED		

SH saunders havill group
 Saunders Havill Group Pty Ltd ABN 24 144 592 540
 head office 9 Thompson St Bowen Hills Q 4006
 phone 090 423 5142 web www.saundershavill.com
 ■ surveying ■ town planning ■ urban design ■ environmental management ■ landscape architecture



THE POCKET - STAGE 5A & 5B
JO-ANN MILLER DRIVE, COLLINGWOOD PARK
PLAN OF ADAC SURVEY DATA
WATER RETICULATION 22-PNT-63005


DRAWING STATUS AS CONSTRUCTED	
SHEET 1 OF 5 SHEETS	
DRAWING NO.	REV. A

Drawing No: 9641 S 43 AC A

SEE SHEET 5



	Hydrant
	Valve
	Bend
	Water Fitting
	Dead End Cap
	Reducer
	Water Meter
	Conduit Crossing and Service Pipe

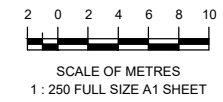

A1

REV NO	DATE	REVISION PURPOSE / DESCRIPTION	DRAWN	RPEQ	RPEQ No
A	29.11.2023	Builders Issue			

DRAWN	TG	21.11.2023
CHECKED	CU	06.12.2023
APPROVED		

SH saunders havill group
 Saunders Havill Group Pty Ltd ABN 54 144 572 540
 head office 5 Thompson St Bowen Hills Q 4006
 phone 0900 633 5161 web www.saundershavill.com
 ■ surveying ■ town planning ■ urban design ■ environmental management ■ landscape architecture
 Drawing No: 9641 S 43 AC A



THE POCKET - STAGE 5A & 5B
 JO-ANN MILLER DRIVE, COLLINGWOOD PARK
 PLAN OF ADAC SURVEY DATA
 WATER RETICULATION 22-PNT-63005

DRAWING STATUS AS CONSTRUCTED	
SHEET 2 OF 5 SHEETS	
DRAWING NO.	REV. A



A1									
REV NO	DATE	REVISION PURPOSE / DESCRIPTION	DRAWN	RPEQ	RPEQ No	INITIALS	DATE		
A	29.11.2023	Builders Issue							

DRAWN	TG	21.11.2023
CHECKED	CU	06.12.2023
APPROVED		

SH saunders havill group
 Saunders Havill Group Pty Ltd ABN 54 144 572 540
 head office 9 Thompson St Bowen Hills Q 4006
 phone: 0900 629 516 web: www.saundershavill.com
 ■ surveying ■ town planning ■ urban design ■ environmental management ■ landscape architecture
 Drawing No: 9641 S 43 AC A



THE POCKET - STAGE 5A & 5B
JO-ANN MILLER DRIVE, COLLINGWOOD PARK
 PLAN OF ADAC SURVEY DATA
 WATER RETICULATION 22-PNT-63005

DRAWING STATUS AS CONSTRUCTED	
SHEET 3 OF 5 SHEETS	
DRAWING NO.	REV.
	A




COLLINGWOOD DRIVE



WATER FITTINGS LEGEND

	Hydrant
	Valve
	Bend
	Water Fitting
	Dead End Cap
	Reducer
	Water Meter
	Conduit Crossing and Service Pipe

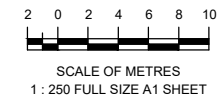

A1

REV NO	DATE	REVISION PURPOSE / DESCRIPTION	DRAWN	RPEQ	RPEQ No
A	29.11.2023	Builders Issue			

APPROVED	INITIALS	DATE
DRAWN	TG	21.11.2023
CHECKED	CU	06.12.2023

SH saunders havill group
 Saunders Havill Group Pty Ltd ABN 54 144 572 540
 head office 9 Thompson St Bowen Hills Q 4006
 phone 090 429 5142 www.saundershavill.com
 ■ surveying ■ town planning ■ urban design ■ environmental management ■ landscape architecture

Drawing No: 9641 S 43 AC A




THE POCKET - STAGE 5A & 5B
JO-ANN MILLER DRIVE, COLLINGWOOD PARK
PLAN OF ADAC SURVEY DATA
WATER RETICULATION 22-PNT-63005

DRAWING STATUS AS CONSTRUCTED	
SHEET 4 OF 5 SHEETS	
DRAWING NO.	REV. A



SEE SHEET 2

WATER FITTINGS LEGEND	
	Hydrant
	Valve
	Bend
	Water Fitting
	Dead End Cap
	Reducer
	Water Meter
	Conduit Crossing and Service Pipe

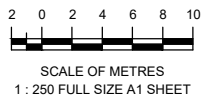

A1

REV NO	DATE	REVISION PURPOSE / DESCRIPTION	DRAWN	RPEQ	RPEQ No
A	29.11.2023	Builders Issue			

DRAWN	TG	21.11.2023
CHECKED	CU	06.12.2023
APPROVED		

SH saunders havill group
 Saunders Havill Group Pty Ltd ABN 54 144 572 540
 head office 9 Thompson St Bowen Hills Q 4006
 phone 0900 633 516 web www.saundershavill.com
 ■ surveying ■ town planning ■ urban design ■ environmental management ■ landscape architecture



THE POCKET - STAGE 5A & 5B
 JO-ANN MILLER DRIVE, COLLINGWOOD PARK
 PLAN OF ADAC SURVEY DATA
 WATER RETICULATION 22-PNT-63005

DRAWING STATUS AS CONSTRUCTED	
SHEET 5 OF 5 SHEETS	
DRAWING NO.	REV. A

Drawing No: 9641 S 43 AC A