




AS CONSTRUCTED

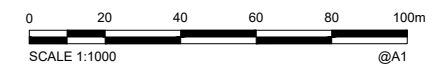

A1	INDEX	DATE	REVISIONS	DRAWN	CHECKED	PASSED
	A	08/12/2023	Builder's Issue			

DRAWN	TG	23.11.23
CHECKED	CU	06.12.23
PASSED		
INITIALS	DATE	

SH saunders havill group
 Brisbane Springfield
 head office 9 Thompson St Bowen Hills Q 4006
 phone 1300 423 SHG web www.saundershavill.com
 Drawing No: 9641 S 44 AC A

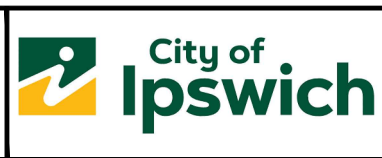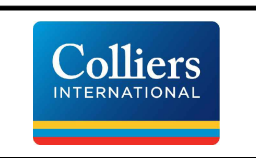

IPSWICH CITY COUNCIL
 AS CONSTRUCTED - ROADS & DRAINAGE
 THE POCKET - STAGE 5A & 5B
 JO-ANN MILLER DRIVE, COLLINGWOOD PARK

SCALE	1:250
SHEET	1 OF 5 SHEETS
DRAWING NO.	



A1	INDEX	DATE	REVISIONS	DRAWN	CHECKED	PASSED
	A	08/12/2023	Builder's Issue			

DRAWN	TG	23.11.23
CHECKED	CU	06.12.23
PASSED		
INITIALS	DATE	

saunders havill group
 Brisbane Springfield
 head office 9 Thompson St Bowen Hills Q 4006
 phone 1300 423 SHG web www.saundershavill.com
 Drawing No: 9641 S 44 AC A

Colliers INTERNATIONAL

City of Ipswich

IPSWICH CITY COUNCIL
 AS CONSTRUCTED - ROADS & DRAINAGE
 THE POCKET - STAGE 5A & 5B
 JO-ANN MILLER DRIVE, COLLINGWOOD PARK


SCALE	1:250
SHEET	3 OF 5 SHEETS
DRAWING NO.	




COLLINGWOOD DRIVE

MALLOW COURT

1000

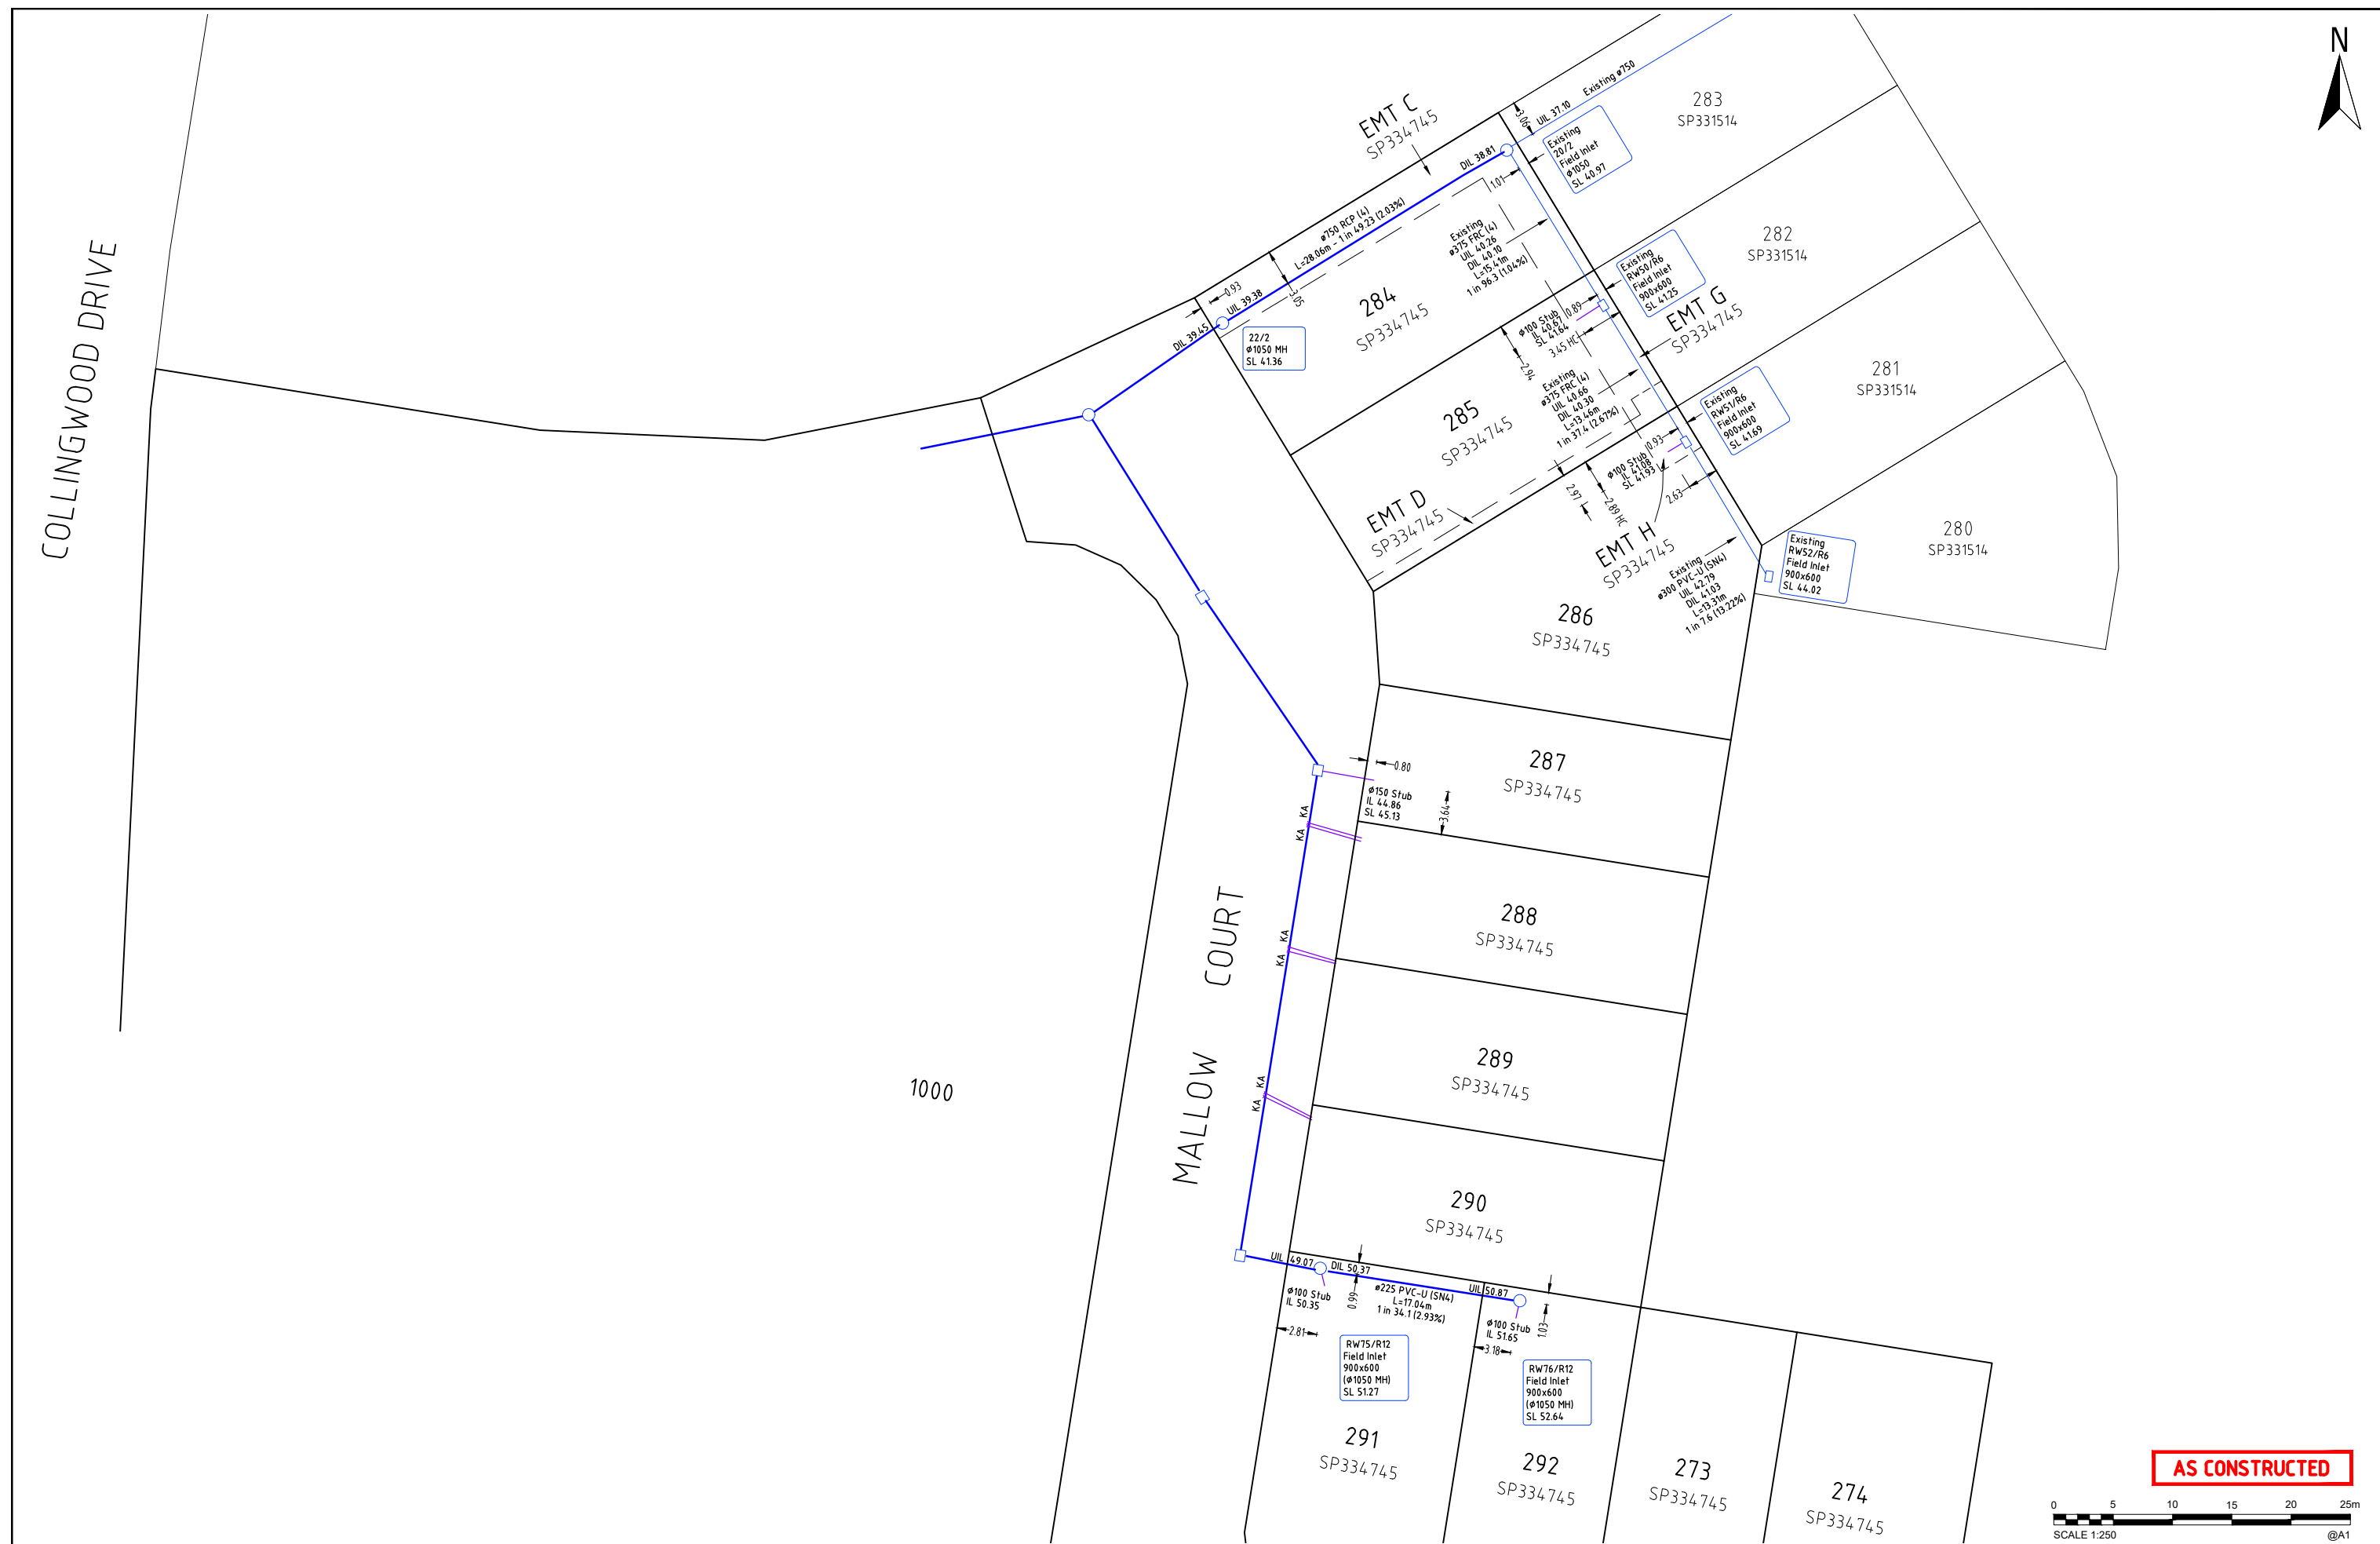



AS CONSTRUCTED

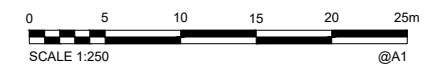

A1						
	A	08/12/2023	Builder's Issue			
INDEX	DATE	REVISIONS	DRAWN	CHECKED	PASSED	

DRAWN	TG	23.11.23
CHECKED	CU	06.12.23
PASSED		
INITIALS	DATE	

SH saunders havill group
 Brisbane Springfield
 head office 9 Thompson St Bowen Hills Q 4006
 phone 1300 123 SHG web www.saundershavill.com
 Drawing No: 9641 S 44 AC A

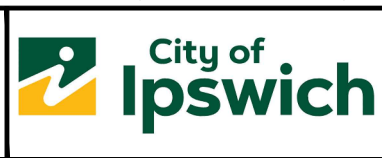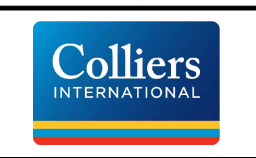


IPSWICH CITY COUNCIL
 AS CONSTRUCTED - ROADS & DRAINAGE
 THE POCKET - STAGE 5A & 5B
 JO-ANN MILLER DRIVE, COLLINGWOOD PARK

SCALE	1:250
SHEET	4 OF 5 SHEETS
DRAWING NO.	




AS CONSTRUCTED

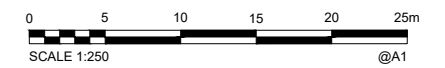

A1						
	A	08/12/2023	Builder's Issue			
INDEX	DATE	REVISIONS	DRAWN	CHECKED	PASSED	

DRAWN	TG	23.11.23
CHECKED	CU	06.12.23
PASSED		
INITIALS	DATE	

SH saunders havill group
 Brisbane Springfield
 head office 9 Thompson St Bowen Hills Q 4006
 phone 1300 423 SHG web www.saundershavill.com
 Drawing No: 9641 S 44 AC A

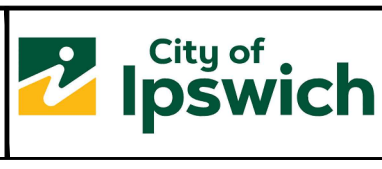

IPSWICH CITY COUNCIL
 AS CONSTRUCTED - ROADS & DRAINAGE
 THE POCKET - STAGE 5A & 5B
 JO-ANN MILLER DRIVE, COLLINGWOOD PARK

SCALE	1:250
SHEET	5 OF 5 SHEETS
DRAWING NO.	