



**AS CONSTRUCTED**

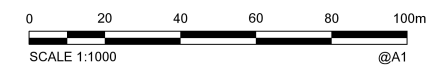

<b>A1</b>	INDEX	DATE	REVISIONS	DRAWN	CHECKED	PASSED
	A	08/12/2023	Builder's Issue			

DRAWN	TG	23.11.23
CHECKED	CU	06.12.23
PASSED		
INITIALS	DATE	

**saunders havill group**  
 Brisbane Springfield  
 head office 9 Thompson St Bowen Hills Q 4006  
 phone 1300 423 SHG web www.saundershavill.com  
 Drawing No: 9641 S 44 AC A

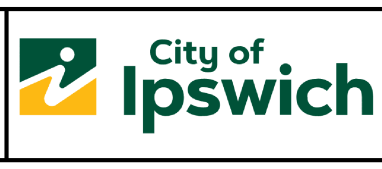


**IPSWICH CITY COUNCIL**  
 AS CONSTRUCTED - ROADS & DRAINAGE  
 THE POCKET - STAGE 5A & 5B  
 JO-ANN MILLER DRIVE, COLLINGWOOD PARK

SCALE	1:250
SHEET	1 OF 5 SHEETS
DRAWING NO.	



AS CONSTRUCTED

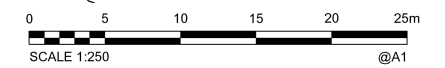

A1	INDEX	DATE	REVISIONS	DRAWN	CHECKED	PASSED
	A	08/12/2023	Builders Issue			

DRAWN	TG	23.11.23
CHECKED	CU	06.12.23
PASSED		
INITIALS	DATE	

**saunders havill group**  
 Brisbane Springfield  
 head office 9 Thompson St Bowen Hills Q 4006  
 phone 1300 423 SHG web www.saundershavill.com  
 Drawing No: 9641 S 44 AC A

**Colliers INTERNATIONAL**

**City of Ipswich**

IPSWICH CITY COUNCIL  
 AS CONSTRUCTED - ROADS & DRAINAGE  
 THE POCKET - STAGE 5A & 5B  
 JO-ANN MILLER DRIVE, COLLINGWOOD PARK

SCALE	1:250
SHEET	2 OF 5 SHEETS
DRAWING NO.	



A1	INDEX	DATE	REVISIONS	DRAWN	CHECKED	PASSED
	A	08/12/2023	Builder's Issue			

DRAWN	TG	23.11.23
CHECKED	CU	06.12.23
PASSED		
INITIALS	DATE	

**saunders havill group**  
 Brisbane Springfield  
 head office 9 Thompson St Bowen Hills Q 4006  
 phone 1300 423 SHG web www.saundershavill.com  
 Drawing No: 9641 S 44 AC A

**Colliers INTERNATIONAL**

**City of Ipswich**

**IPSWICH CITY COUNCIL**  
 AS CONSTRUCTED - ROADS & DRAINAGE  
 THE POCKET - STAGE 5A & 5B  
 JO-ANN MILLER DRIVE, COLLINGWOOD PARK


SCALE	1:250
SHEET	3 OF 5 SHEETS
DRAWING NO.	




COLLINGWOOD DRIVE

MALLOW COURT

1000

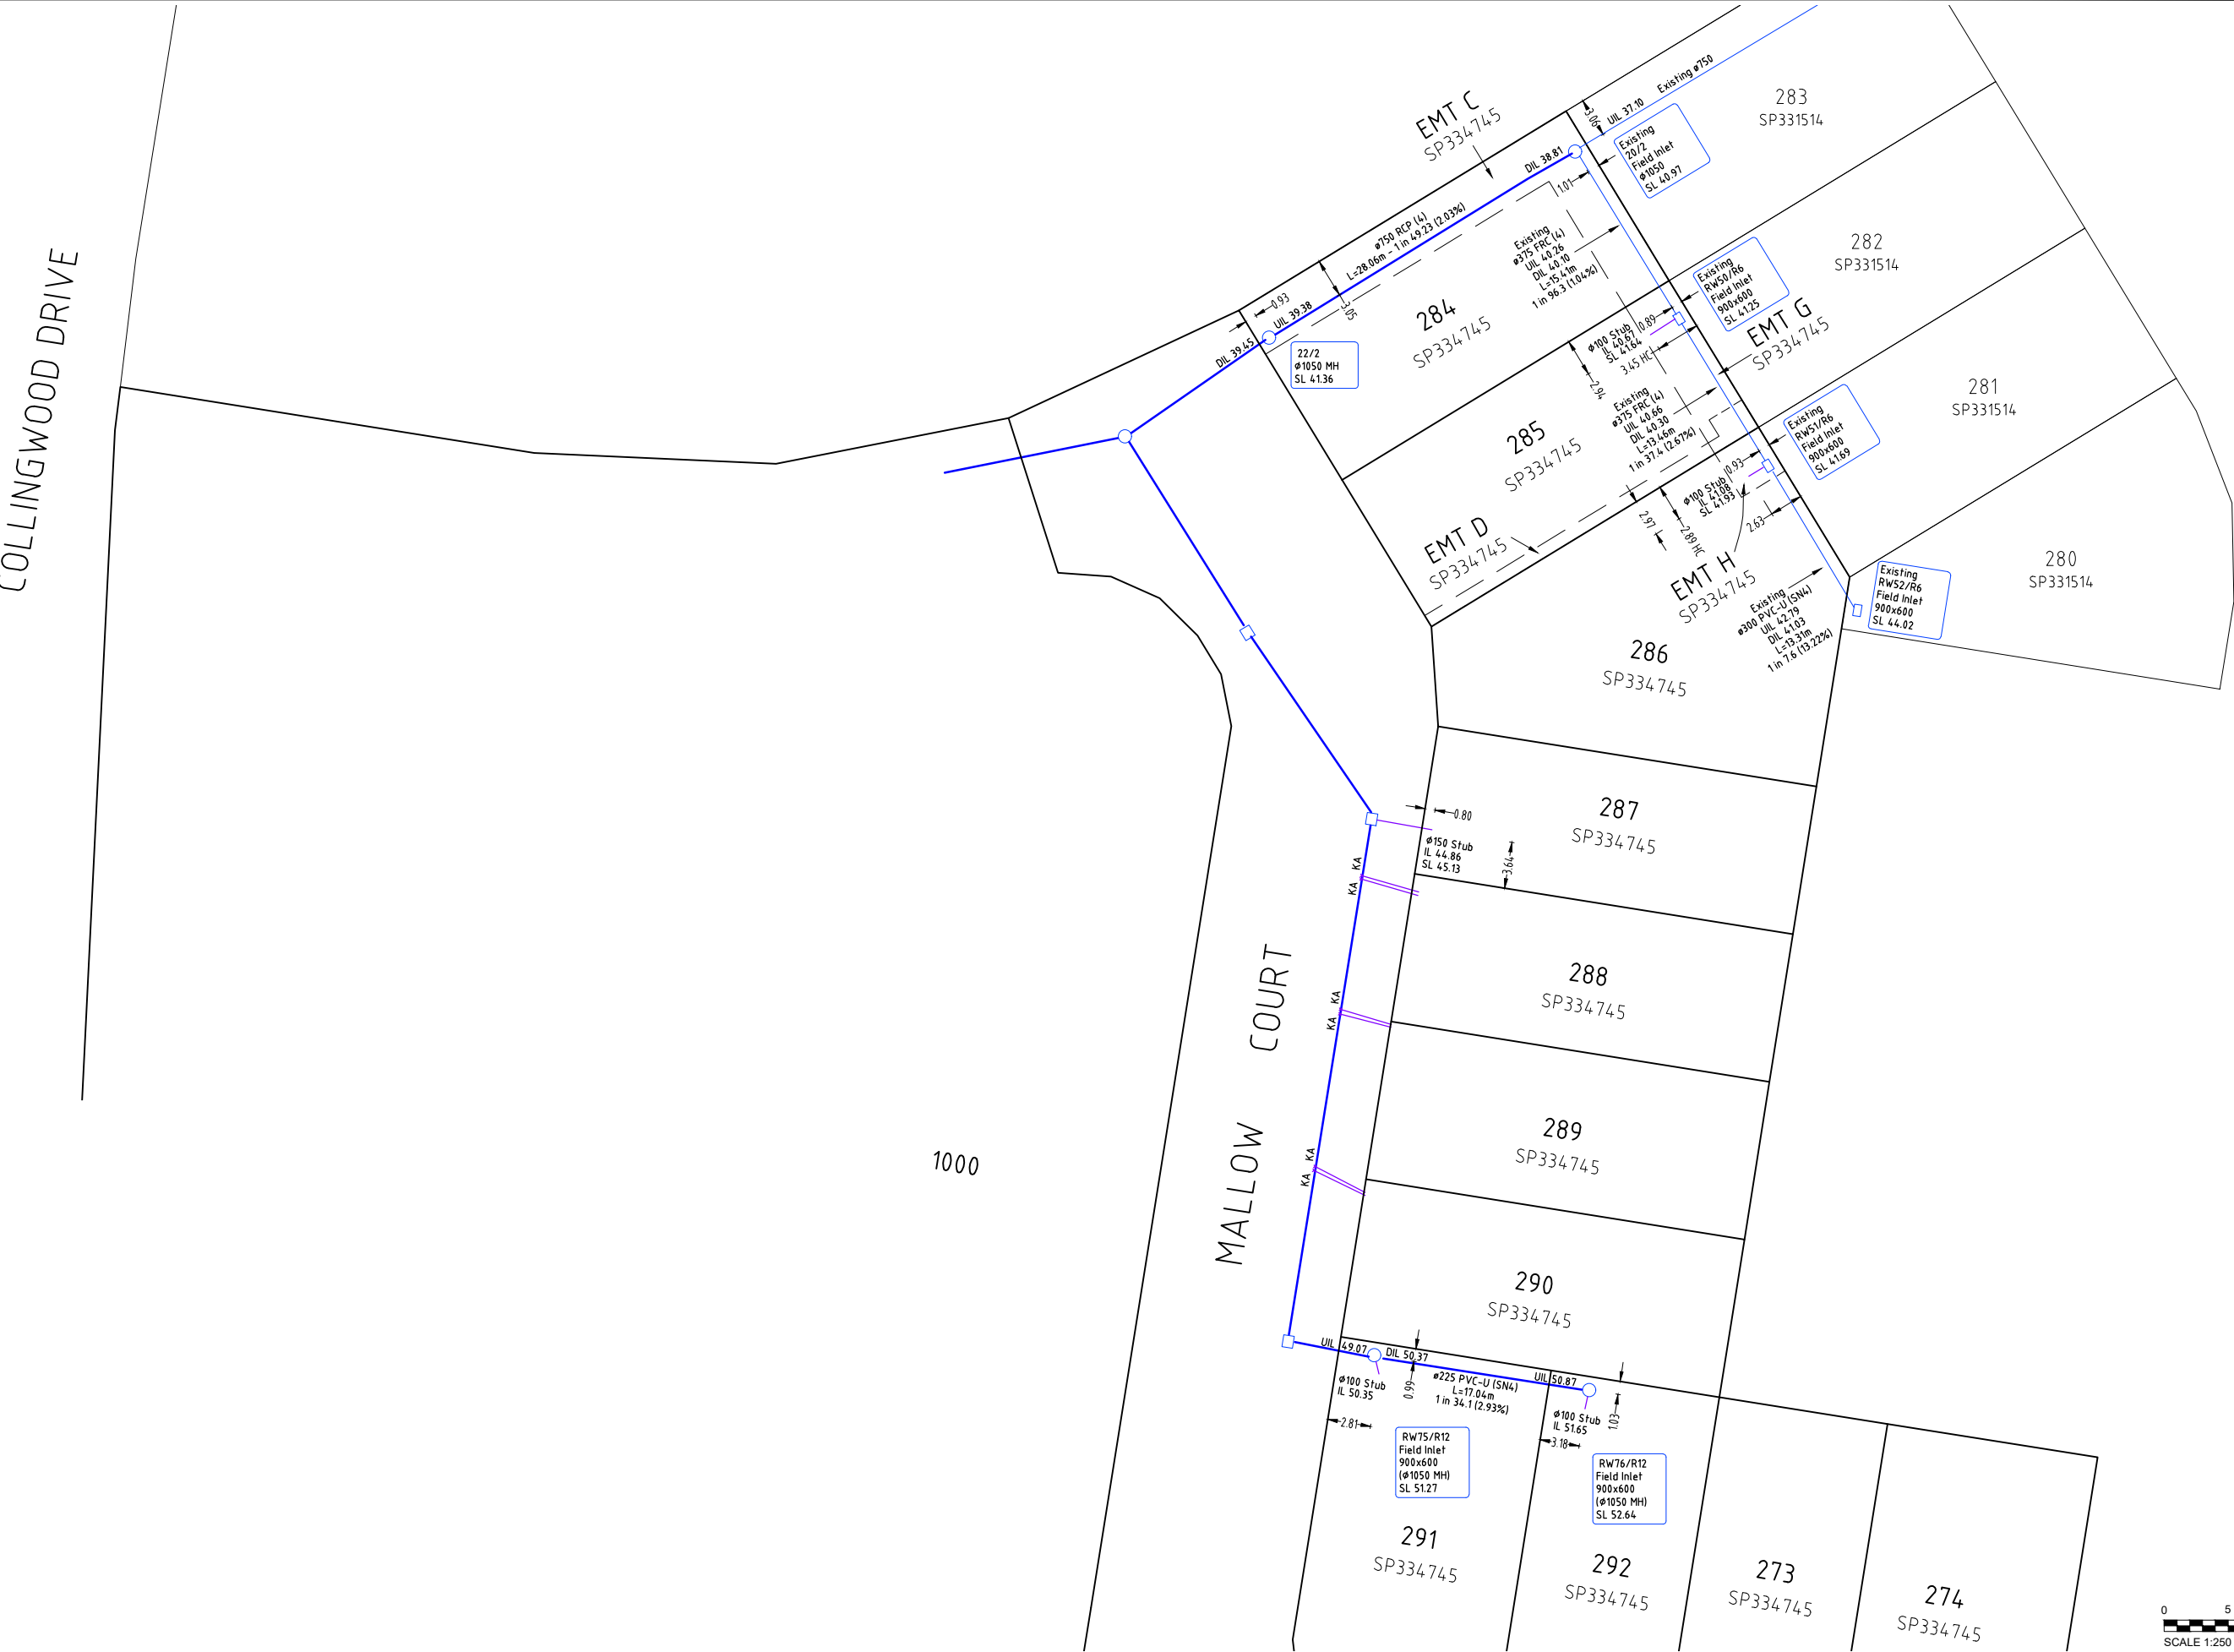

AS CONSTRUCTED


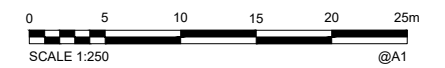


A1

INDEX	DATE	REVISIONS	DRAWN	CHECKED	PASSED
A	08/12/2023	Builder's Issue			

INITIALS	DATE
DRAWN TG	23.11.23
CHECKED CU	06.12.23
PASSED	

**saunders havill group**  
 Brisbane Springfield  
 head office 9 Thompson St Bowen Hills Q 4006  
 phone 1300 423 SHG web www.saundershavill.com  
 Drawing No: 9641 S 44 AC A

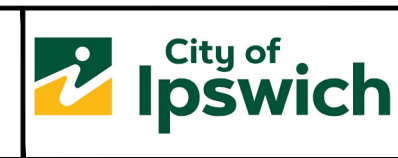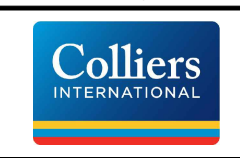


**IPSWICH CITY COUNCIL**  
 AS CONSTRUCTED - ROADS & DRAINAGE  
 THE POCKET - STAGE 5A & 5B  
 JO-ANN MILLER DRIVE, COLLINGWOOD PARK

SCALE	SHEET	OF	SHEETS
1:250	4	OF	5
DRAWING NO.			




**AS CONSTRUCTED**

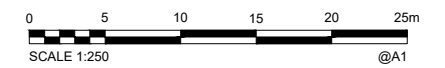

<b>A1</b>						
	A	08/12/2023	Builder's Issue			
INDEX	DATE	REVISIONS	DRAWN	CHECKED	PASSED	

DRAWN	TG	23.11.23
CHECKED	CU	06.12.23
PASSED		
INITIALS	DATE	

**SH saunders havill group**  
 Brisbane Springfield  
 head office 9 Thompson St Bowen Hills Q 4006  
 phone 1300 423 SHG web www.saundershavill.com  
 Drawing No: 9641 S 44 AC A

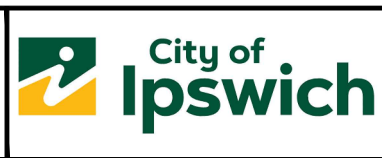

**IPSWICH CITY COUNCIL**  
 AS CONSTRUCTED - ROADS & DRAINAGE  
 THE POCKET - STAGE 5A & 5B  
 JO-ANN MILLER DRIVE, COLLINGWOOD PARK

SCALE	1:250
SHEET	5 OF 5 SHEETS
DRAWING NO.	