


ADAC Verification Plot

Project Name: The Pocket - Stage 1
 Description: Subdivision
 Works Approval ID: 3769/2019/MAMC/A
 Receiver: Ipswich City Council
 Construction date: 2022-09-21
 Status: As Constructed

ADAC version: 5.0.1
 Horizontal coordinates: MGA zone 56 (GDA2020)
 Vertical datum: AHD derived
 Notes: Vertical Origin: PM110122, RL 40.32
 Surveyor: Saunders Havill Group (Reg ID 4611)
 Engineer: PeakUrban

Note: See ADAC xml file for full attribute information

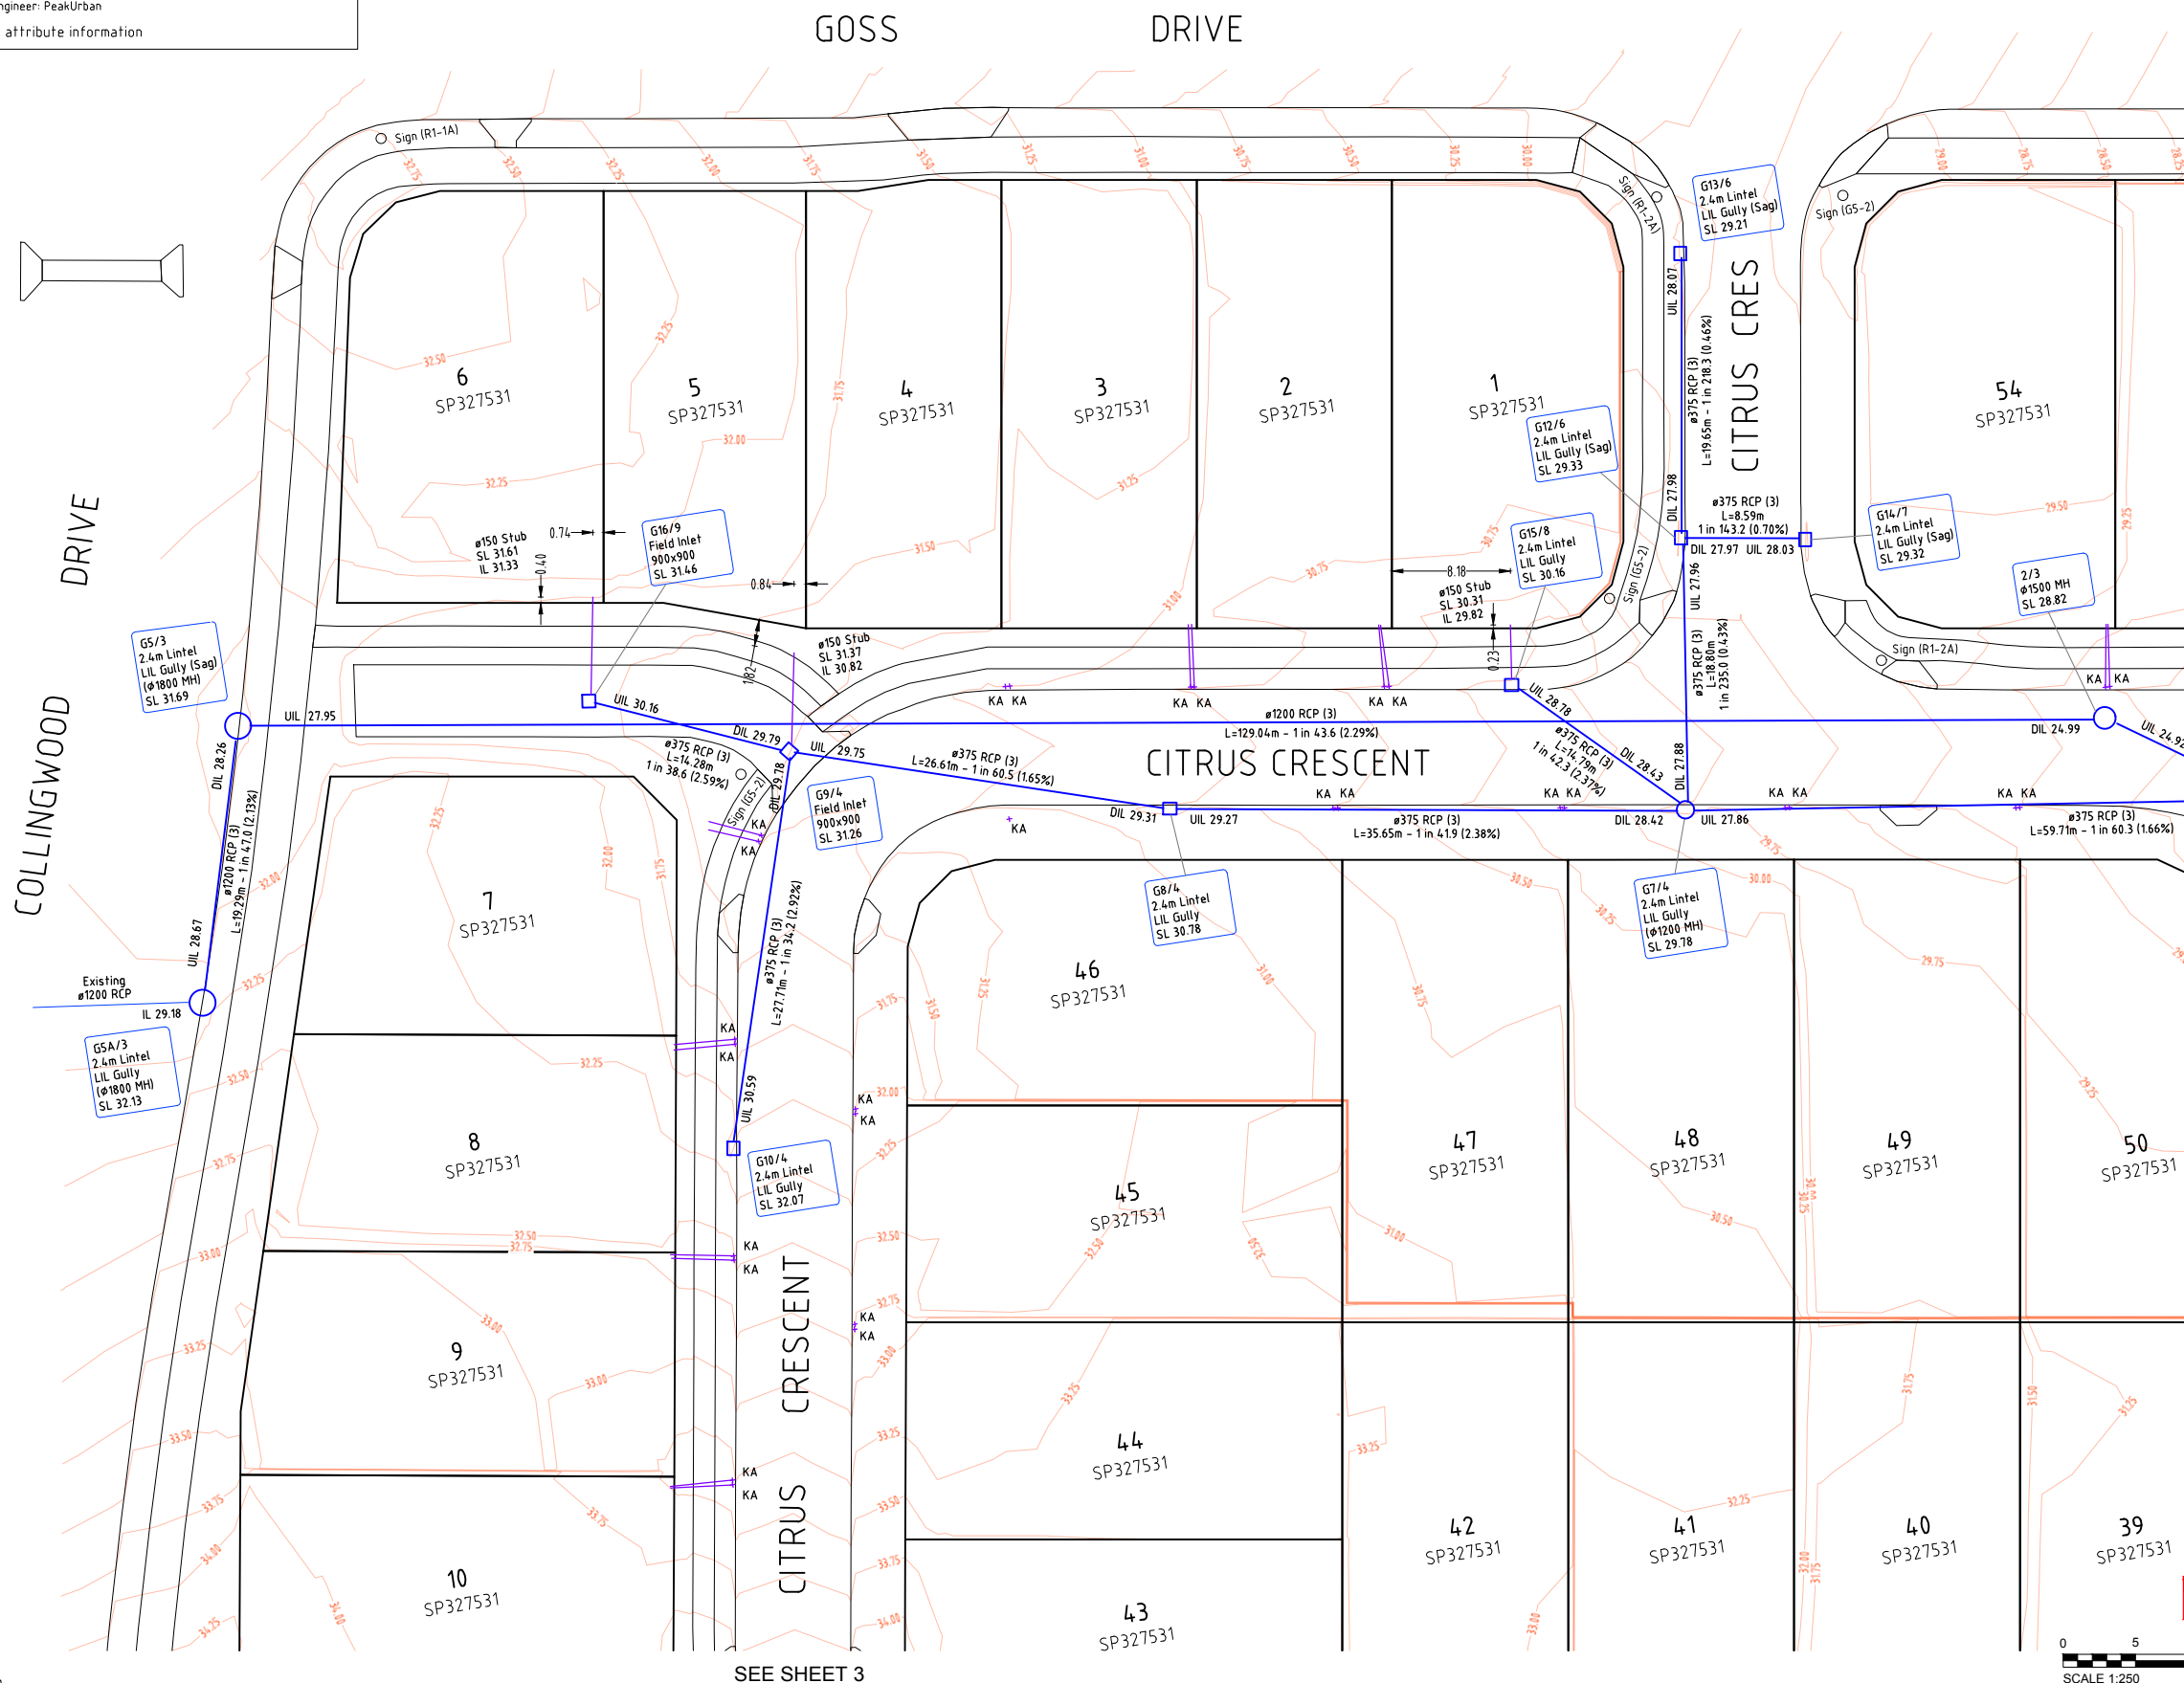

REGISTERED SURVEYOR'S CERTIFICATION
 THE POCKET - STAGE 1
 Saunders Havill Group Pty Ltd, Registered Surveyor, hereby certify that the vertical and horizontal locations and dimensions shown on this plan are a true and correct record and were located by survey.
 M. Kline 4611 15/02/2023
 Authorised Signatory Reg. Surveyor No. Date

AS CONSTRUCTED CERTIFICATION
 THE POCKET - STAGE 1
 (Company's representative Name) (Signature)
 (Date) (RPEQ)
 Being a duly representative of- (Company Name)
 Hereby certify that
 1. The information contained in this drawing / document is in compliance with approved drawings and design supplied under the terms of the contract.
 2. This represents an accurate "As constructed" record of works carried out and accept responsibility for the information contained in this drawing / document.

COORDINATE DATUM NOTE:
 HORIZONTAL COORDINATES (E,N) SUPPLIED ARE MAPPING GRID OF AUSTRALIA (MGA), ZONE 56 BASED ON THE UNIVERSAL TRANSVERSE MERCATOR PROJECTION AND THE GEOCENTRIC DATUM OF AUSTRALIA 2020.

SEE SHEET 2

SEE SHEET 3

AS CONSTRUCTED



A1	INDEX	DATE	REVISIONS	DRAWN	CHECKED	PASSED
	A	15.02.2023	Original Issue			

DRAWN	CM	07/11/2022
CHECKED	MK	07/11/2022
PASSED		
INITIALS	DATE	

saunders havill group
 Brisbane Springfield
 head office 9 Thompson St Bowen Hills Q 4006
 phone 1300 123 SHG web www.saundershavill.com
 Drawing No: 9641 S 27 AC A

PEAKURBAN
 Achieve more.
 ENQUIRES@PEAKURBAN.COM.AU

City of Ipswich

IPSWICH CITY COUNCIL
 AS CONSTRUCTED - ROADS & DRAINAGE
 THE POCKET - STAGE 1
 COLLINGWOOD DRIVE / GOSS DRIVE, COLLINGWOOD PARK

SCALE	1:250
SHEET	1 OF 4 SHEETS
DRAWING NO.	

ADAC Verification Plot

Project Name: The Pocket - Stage 1
 Description: Subdivision
 Works Approval ID: 3769/2019/MAMC/A
 Receiver: Ipswich City Council
 Construction date: 2022-09-21
 Status: As Constructed

ADAC version: 5.0.1
 Horizontal coordinates: MGA zone 56 (GDA2020)
 Vertical datum: AHD derived
 Notes: Vertical Origin: PM110122, RL 40.32
 Surveyor: Saunders Havill Group (Reg ID 4611)
 Engineer: PeakUrban

Note: See ADAC xml file for full attribute information



REGISTERED SURVEYOR'S CERTIFICATION
 THE POCKET - STAGE 1



Saunders Havill Group Pty Ltd, Registered Surveyor, hereby certify that the vertical and horizontal locations and dimensions shown on this plan are a true and correct record and were located by survey.

M. Kleine 4611 15/02/2023
 Authorised Signatory Reg. Surveyor No. Date

AS CONSTRUCTED CERTIFICATION
 THE POCKET - STAGE 1

(Company's representative Name) (Signature)
 (Date) (RPEQ)
 Being a duly representative of- (Company Name)

Hereby certify that
 1. The information contained in this drawing / document is in compliance with approved drawings and design supplied under the terms of the contract.
 2. This represents an accurate "As constructed" record of works carried out and accept responsibility for the information contained in this drawing / document.

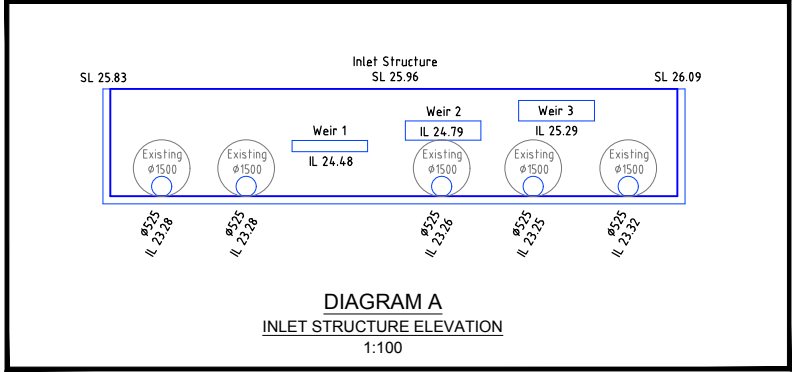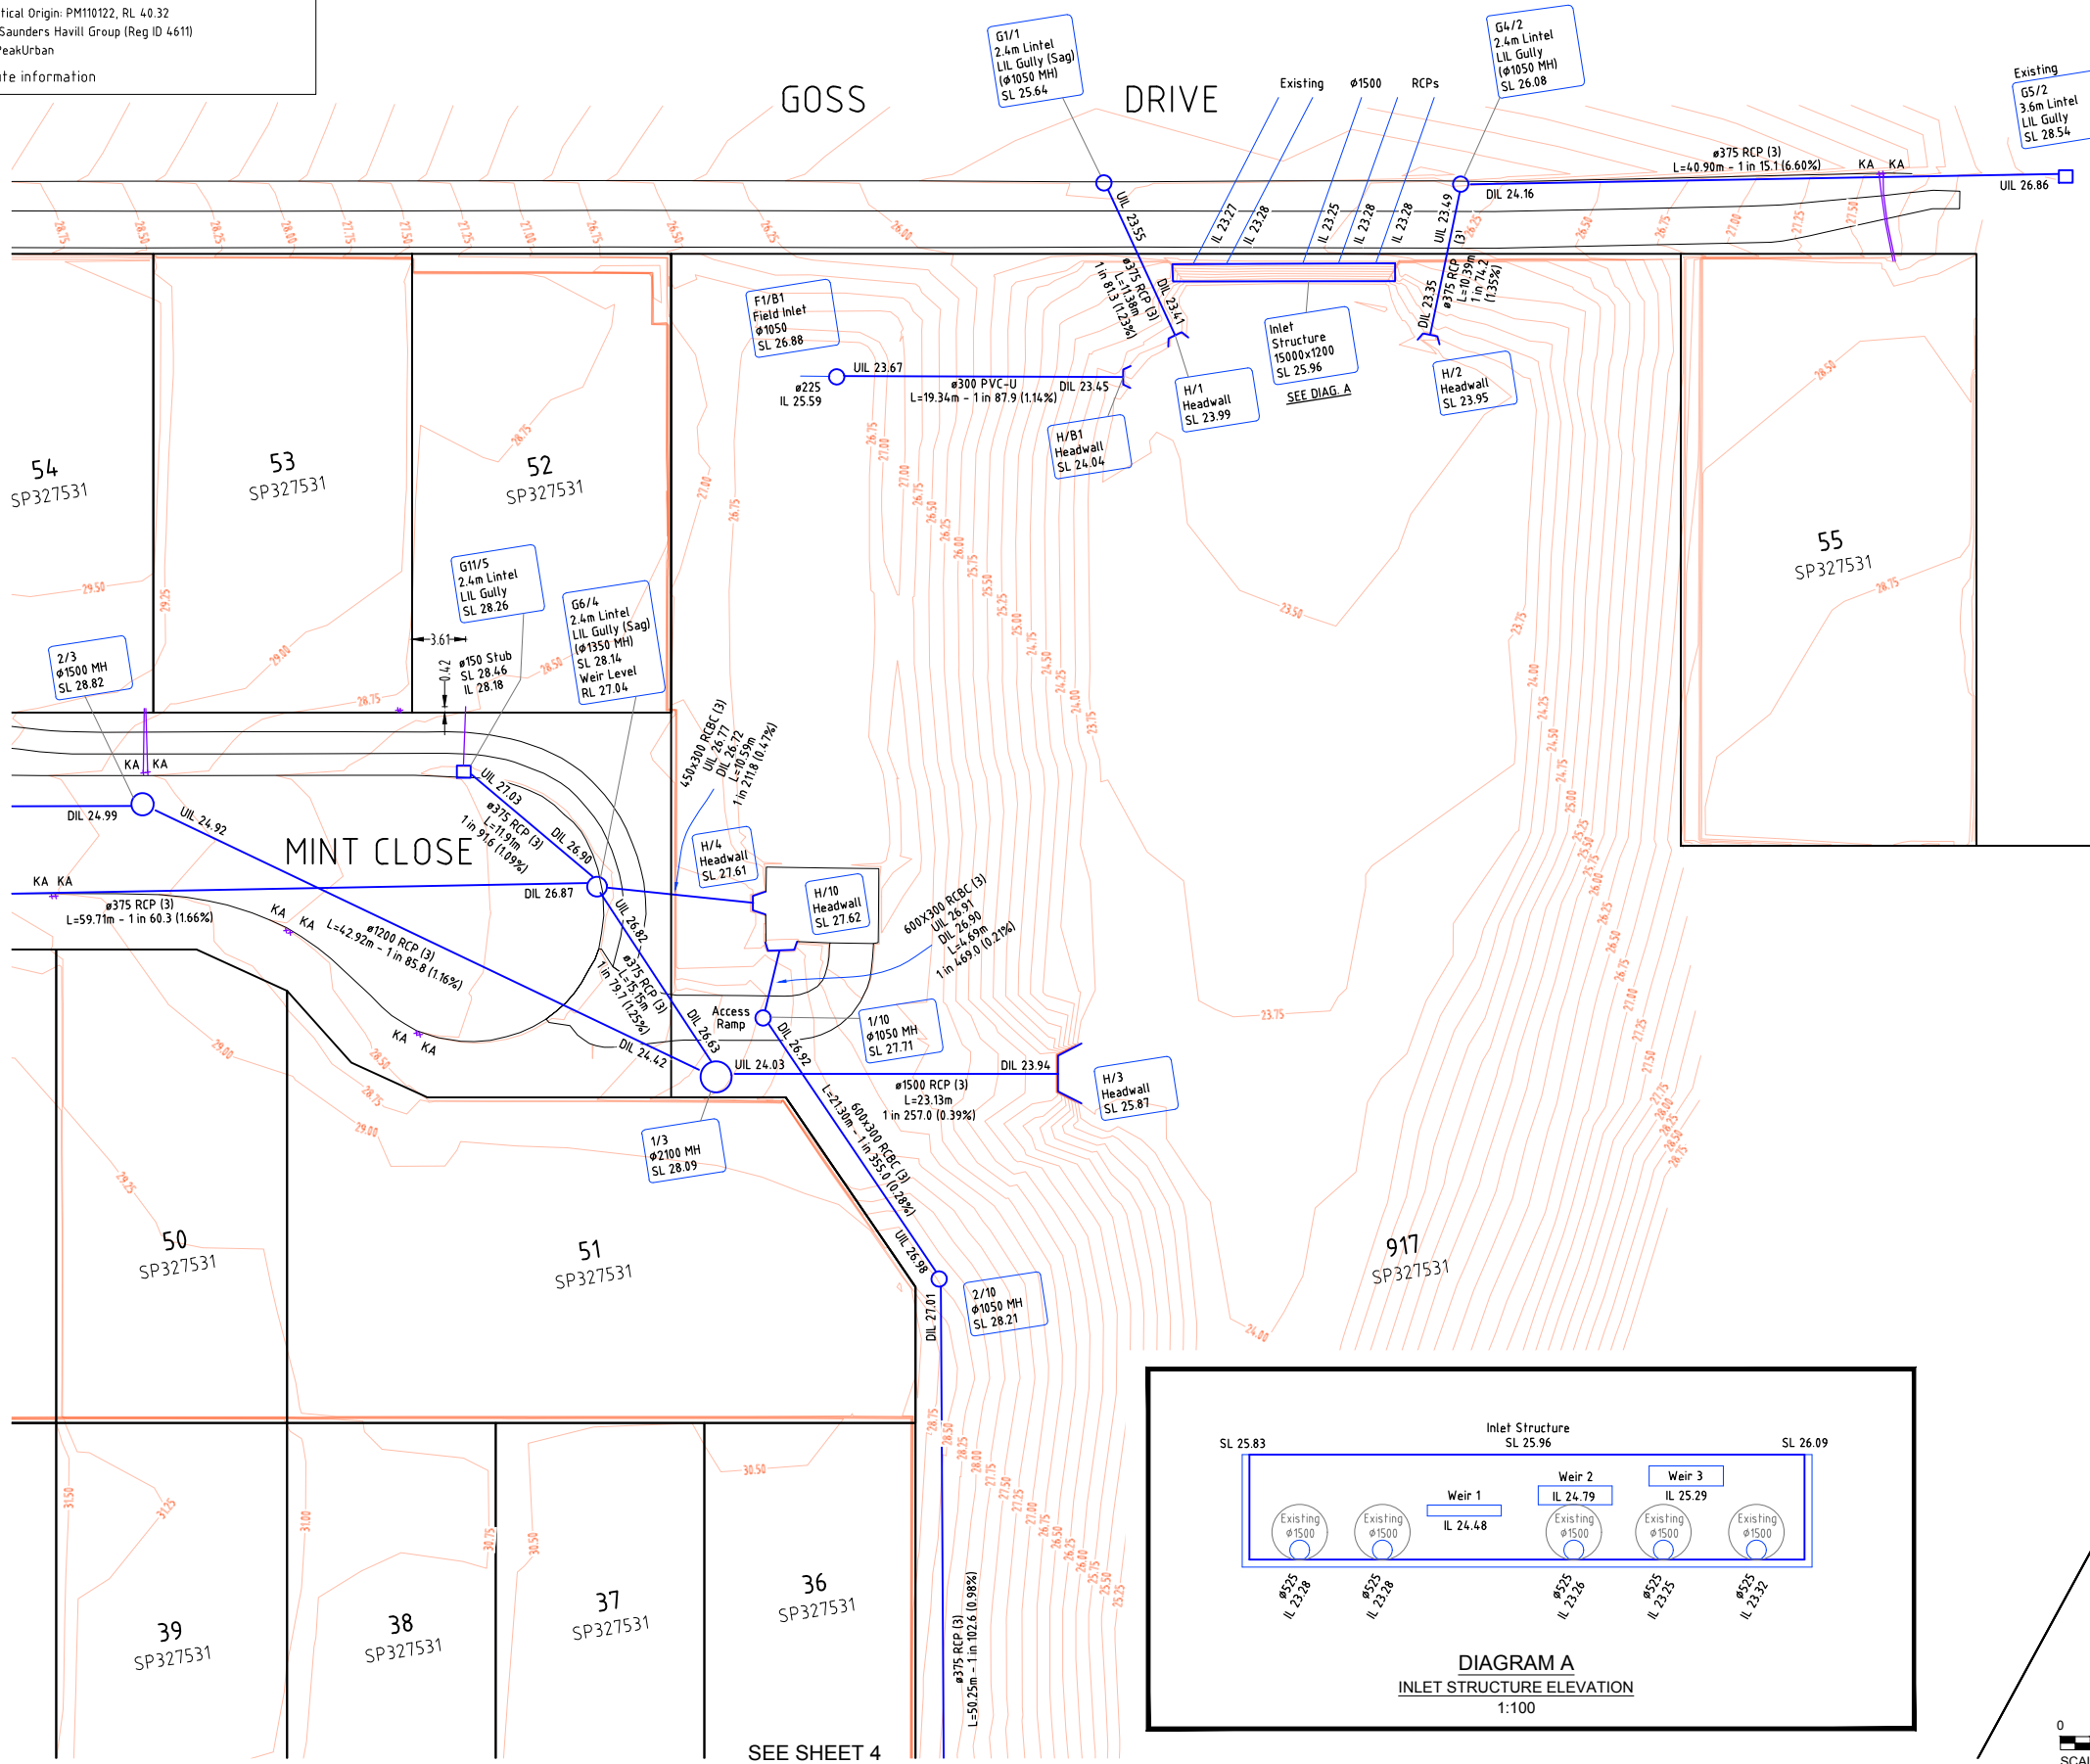

1000 (P1)

CONTOUR INTERVAL: 0.25m

AS CONSTRUCTED



COORDINATE DATUM NOTE:
 HORIZONTAL COORDINATES (E,N) SUPPLIED ARE MAPPING GRID OF AUSTRALIA (MGA), ZONE 56 BASED ON THE UNIVERSAL TRANSVERSE MERCATOR PROJECTION AND THE GEOCENTRIC DATUM OF AUSTRALIA 2020.

A1	INDEX	DATE	REVISIONS	DRAWN	CHECKED	PASSED
	A	15.02.2023	Original Issue			

DRAWN	CM	07/11/2022
CHECKED	MK	07/11/2022
PASSED		
INITIALS	DATE	

saunders havill group
 Brisbane Springfield head office 9 Thompson St Bowen Hills Q 4006 phone 1300 423 SHG web www.saundershavill.com
 Drawing No: 9641 S 27 AC A

PEAKURBAN
 Achieve more.
 ENQUIRIES@PEAKURBAN.COM.AU

City of Ipswich

IPSWICH CITY COUNCIL
 AS CONSTRUCTED - ROADS & DRAINAGE
 THE POCKET - STAGE 1
 COLLINGWOOD DRIVE / GOSS DRIVE, COLLINGWOOD PARK

SCALE	1:250
SHEET	2 OF 4 SHEETS
DRAWING NO.	

ADAC Verification Plot

Project Name: The Pocket - Stage 1
 Description: Subdivision
 Works Approval ID: 3769/2019/MAMC/A
 Receiver: Ipswich City Council
 Construction date: 2022-09-21
 Status: As Constructed

ADAC version: 5.0.1
 Horizontal coordinates: MGA zone 56 (GDA2020)
 Vertical datum: AHD derived
 Notes: Vertical Origin: PM110122, RL 40.32
 Surveyor: Saunders Havill Group (Reg ID 4611)
 Engineer: PeakUrban

Note: See ADAC xml file for full attribute information



REGISTERED SURVEYOR'S CERTIFICATION


THE POCKET - STAGE 1
 Saunders Havill Group Pty Ltd, Registered Surveyor, hereby certify that the vertical and horizontal locations and dimensions shown on this plan are a true and correct record and were located by survey.

M. Klein 4611 15/02/2023
 Authorised Signatory Reg. Surveyor No. Date

AS CONSTRUCTED CERTIFICATION

THE POCKET - STAGE 1
 (Company's representative Name) (Signature)
 (Date) (RPEQ)
 Being a duly representative of- (Company Name)
 Hereby certify that
 1. The information contained in this drawing / document is in compliance with approved drawings and design supplied under the terms of the contract.
 2. This represents an accurate "As constructed" record of works carried out and accept responsibility for the information contained in this drawing / document.


SEE SHEET 2

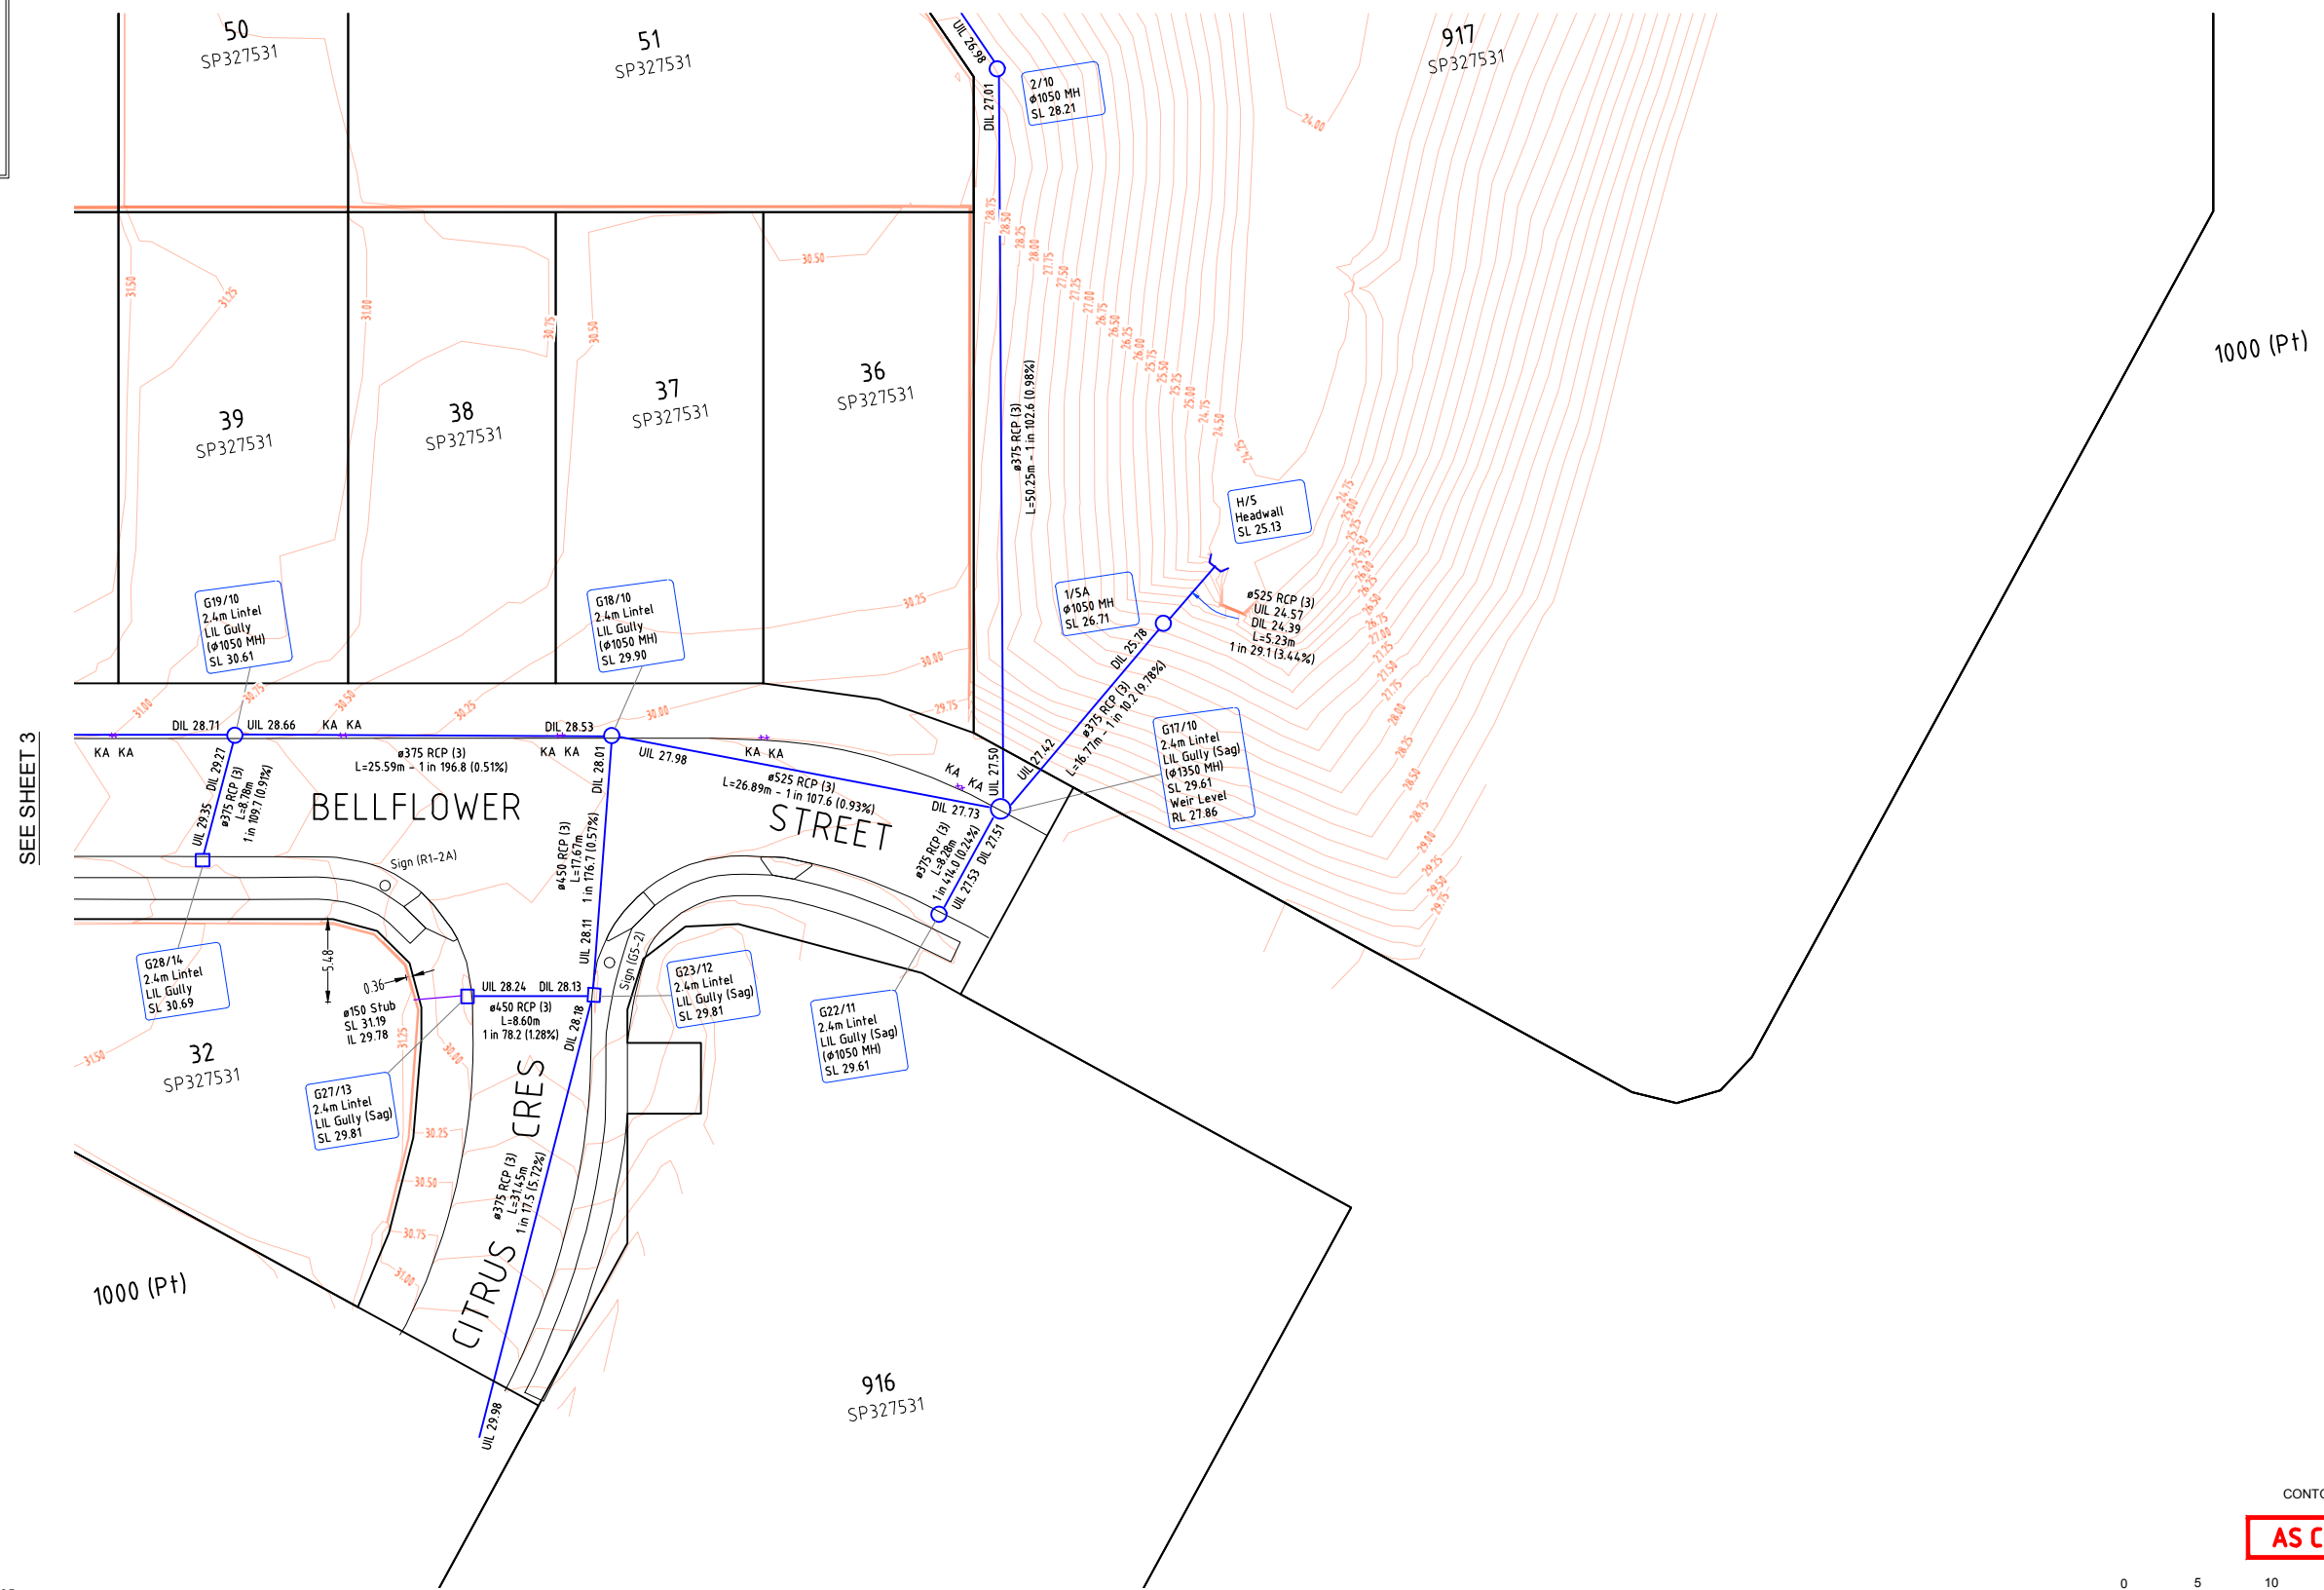

COORDINATE DATUM NOTE:
 HORIZONTAL COORDINATES (E,N) SUPPLIED ARE MAPPING GRID OF AUSTRALIA (MGA), ZONE 56 BASED ON THE UNIVERSAL TRANSVERSE MERCATOR PROJECTION AND THE GEOCENTRIC DATUM OF AUSTRALIA 2020.

CONTOUR INTERVAL: 0.25m

AS CONSTRUCTED

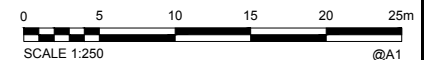

A1

INDEX	DATE	REVISIONS	DRAWN	CHECKED	PASSED
A	15.02.2023	Original Issue			

DRAWN	CM	07/11/2022
CHECKED	MK	07/11/2022
PASSED		
INITIALS	DATE	

saunders havill group
 Brisbane Springfield
 head office 9 Thompson St Bowen Hills Q 4006
 phone 1300 423 516 web www.saundershavill.com
 Drawing No: 6777 S 52 AC A

PEAKURBAN
 Achieve more.
 ENQUIRIES@PEAKURBAN.COM.AU

City of Ipswich

IPSWICH CITY COUNCIL
 AS CONSTRUCTED - ROADS & DRAINAGE
 THE POCKET - STAGE 1
 COLLINGWOOD DRIVE / GOSS DRIVE, COLLINGWOOD PARK

SCALE	1:250
SHEET	4 OF 4 SHEETS
DRAWING NO.	